

MONROE  
A62  
6-5-72

MISSISSIPPI  
BOARD OF WATER COMMISSIONERS  
416 North State Street  
Jackson, Mississippi 39201

WATER WELL DRILLERS LOG

CODED

June 5 1972 Herndon Well & Supply Co. Monroe  
date well completed firm name county well located

LANDOWNER: Howard Ratliff

Route 2, Tupelo, Ms.

38801

(mailing address)

WELL LOCATION:

sec. 18 T 12S N R 6 E E  
S W  
3 NE Okolona  
(distance) miles (direction) of (nearest town)

WELL PURPOSE: hog parlor  
(home, irrigation, municipal, industrial)

WELL COMPLETION DATA:

- (1) diameter (inches) 5"
- (2) total depth (feet) 440'
- (3) static water level (feet) approx 125 below above top of ground.
- (4) casing steel 21' 8" / (material) (depth)  
5" / (size) if telescope see back.
- (5) screen / (length) / (depth to top)  
(size) / (material)
- (6) pump installed later / (HP) / (yield gpm)  
(type power)
- (7) electric log no / (yes or no)  
(organization running log)
- (8) how well bottom plugged open

description of formations encountered

from

to

Red Clay	0	5
White Chalk	5	15
Blue Rock	15	260
Sand	260	440

CODED


REC'D (6/5/72)  
WATER WELL LOGS

MISS. BD. OF  
WATER COM.

DRILLERS REMARKS:  
well drilled & capped

If well telescopes please sketch and show depths.

GROUND LEVEL

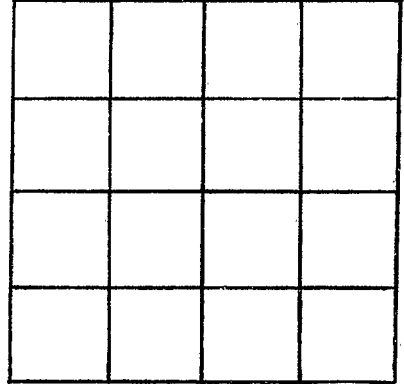

SECTION \_\_\_\_\_

Please indicate well location X.

ADDITIONAL INFORMATION

If more than one screen,  
show locations of each on sketch.