

MONROE
A 63
4-5-72

MISSISSIPPI
 BOARD OF WATER COMMISSIONERS
 416 North State Street
 Jackson, Mississippi 39201

CODED

WATER WELL DRILLERS LOG

April 5, 1972 Herndon Well & Supply Co. Monroe
 date well completed firm name county well located

LANDOWNER:
 Sam Seymore
 Nettleton, Miss. 38858
 (mailing address)

WELL LOCATION:
 sec. 11 12S N R 6E E
 S W
 2 miles SW of Nettleton
 (distance) (direction) (nearest town)

WELL PURPOSE: home
 (home, irrigation, municipal, industrial)

- WELL COMPLETION DATA:
- (1) diameter (inches) 5"
 - (2) total depth (feet) 300 ft
 - (3) static water level (feet) 59 below above top of ground.
 - (4) casing steel 21 ft
 (material) (depth)
 5" if telescope see back.
 (size)
 - (5) screen (length) (depth to top)
 (size) (material)
 - (6) pump hand (HP) (yield gpm)
 (type power)
 - (7) electric log no (yes or no)
 (organization running log)
 - (8) how well bottom plugged open

description of formations encountered	from	to
red clay	0	16
blue clay	16	196
tight sand	196	245
sand	245	300
Red Clay	0	16
Blue Rock	16	196
Tight Sand	196	245
Sand	245	300

CODED


APR 21 1972

MISS. Bd. OF WATER COMM

DRILLERS REMARKS:

If well telescopes please sketch and show depths.

GROUND LEVEL

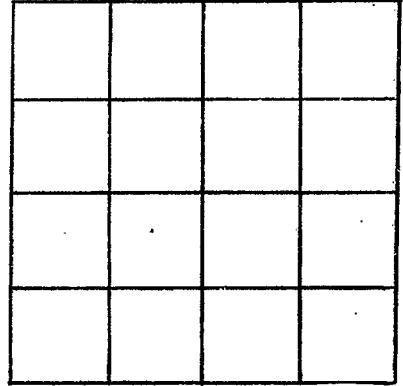

SECTION _____

Please indicate well location X.

ADDITIONAL INFORMATION

If more than one screen,
show locations of each on sketch.