

**MONROE**  
**A65**  
**9-15-72**

MISSISSIPPI  
BOARD OF WATER COMMISSIONERS  
416 North State Street  
Jackson, Mississippi 39201

**CODED**

**WATER WELL DRILLERS LOG**

Herman Homan Well & Supply, Inc.

9/15 1972  
date well completed

P. O. Box 42  
SHANNON, MISSISSIPPI 38868

Monroe  
county well located

**LANDOWNER:**

Roy King  
Attn: Shannon, Miss.  
(mailing address)

**description of formations encountered**

description of formations encountered	from	to
Surface sand & clay	0	15
Blue clay	15	200
Sand	200	340
Bottom	340	

**WELL LOCATION:**

sec. 6 T. 12 N. R. 6 E.  
5 miles SW of Nettleton  
(distance) (direction) (nearest town)

**WELL PURPOSE:**

Home  
(home, irrigation, municipal, industrial)

**WELL COMPLETION DATA:**

- (1) diameter (inches) 5"
- (2) total depth (feet) 340'
- (3) static water level (feet) 80' below top of ground.
- (4) casing steel, 19'4" (material) (depth)  
5" (size) If telescope see back.
- (5) screen no (length) (depth to top)  
(size) (material)
- (6) pump 3/4 (HP) 5 (yield gpm)  
electric (type power)
- (7) electric log no (yes or no)

**CODED**

(organization running log)

(8) how well bottom plugged opened


SEP 28 1972

**DRILLERS REMARKS:**

MISS. BD. OF  
WATER COMMISSIONERS

If well telescopes please sketch and show depths.

GROUND LEVEL

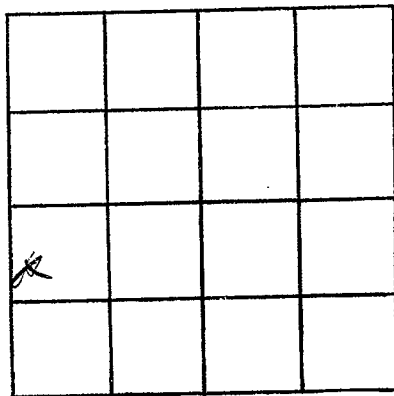

SECTION 6

Please indicate well location X.

ADDITIONAL INFORMATION

If more than one screen,  
show locations of each on sketch.