

MONROE

A 66

11-15-72

MISSISSIPPI
 BOARD OF WATER COMMISSIONERS
 416 North State Street
 Jackson, Mississippi 39201

CODED

WATER WELL DRILLERS LOG

11/15
date well completed

1972 Herman Homan Well & Supply, Inc.

Form No. 42

Monroe
county well located

SHANNON, MISSISSIPPI 38668

LANDOWNER:

Charles M. Watson

22 Nettleton, Miss
(mailing address)

description of formations encountered

Surface clay
Blue clay
Sand
Bottom

from to

0 30
30 260
260 400
400

WELL LOCATION:

sect 15 T. 12 N R. 6 E
2 1/2 miles SW of Nettleton
(distance) (direction) (nearest town)

WELL PURPOSE:

Stone
(home, irrigation, municipal, industrial)

WELL COMPLETION DATA:

- (1) diameter (inches) 5"
- (2) total depth (feet) 400'
- (3) static water level (feet) 129' below top of ground.
- (4) casing Steel, 35' 4" (material), (depth)
5" if telescope see back. (size)
- (5) screen NO (length), (depth to top)
(size), (material)
- (6) pump 1/2 HP, 5 (yield gpm)
electric (type power)
- (7) electric log NO (yes or no)

(organization running log)

(8) how well bottom plugged open


CODED

DEC 11 1972

DRILLERS REMARKS:

If well telescopes please sketch and show depths.

GROUND LEVEL

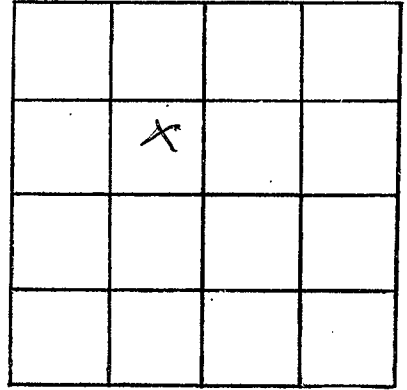

SECTION 15

Please indicate well location X.

ADDITIONAL INFORMATION

If more than one screen, show locations of each on sketch.