

Moaroc
A-67
B-66

MISSISSIPPI BOARD OF WATER COMMISSIONERS

CODED

WATER WELL DRILLERS LOG

Date: Aug. 6, 1966, Driller: Herndon-Homan Well & Supply, Inc. County: Monroe
(When well drilled) P. O. Box 42 (Where well is located)
SHANNON, MISSISSIPPI 38862

(1) Owner of Land: Hoza White
(Name)
At Nettleton, Miss.
(Address)
(2) Location: SE 1/4, NW 1/4, Sec. 25, T. 25, R. 6
5 miles S of Nettleton
(distance) (direction) (Nearest Town)
(3) Topography: Flat
(Hilly) (Flat) (Level)
(4) Purpose of Well: Domestic
(Domestic Irrigation
Municipal, Industrial, Other)


Description & Color of Materials Sand, Clay, Red Clay, Shell, etc.	Thick- ness Feet	Depth Feet
<u>surface sand +</u>		
<u>clay</u>		<u>0-35</u>
<u>Red Clay</u>		<u>35-220</u>
<u>Sand</u>		<u>220-340</u>
<u>Bottom</u>		<u>340</u>

Information upon completion of well:

(1) Diameter: 8 inches.
(2) Total Depth: 340 feet.
(3) Water Level: 120' feet below top of ground.
(4) Cased to: 39', Size: 5"
(5) Screen: Size: none, Length: —
(6) Were any formations sealed against pollution?
✓ yes, — no.

CODED

If YES depth of formation: 35'
Why: surface + ground
Drillers Remarks: no pump installed
Yield in gpm: —
Size pump: —
Type power: —

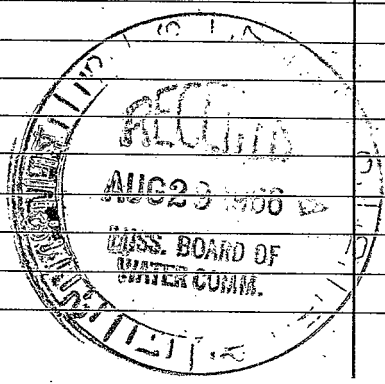

[The page contains extremely faint and illegible text, likely bleed-through from the reverse side of the document. The text is scattered across the page and cannot be transcribed accurately.]