

MONROE

MISSISSIPPI  
BOARD OF WATER COMMISSIONERS  
416 North State Street  
Jackson, Mississippi 39201

CODED

WATER WELL DRILLERS LOG

MONROE

<del>LEE</del>
A 68
5/73

May 19 73 Herndon Well & Supply Co. Lee  
 date well completed firm name county well located

LANDOWNER:	description of formations encountered	from	to
		Bob Smith	Gray Clay
Nettleton, MS (mailing address)	Blue Rock	19	180
	Tight Sand	180	210
	Sand	210	320

WELL LOCATION:  
 sec. 3 T. 12 N. R. 6 E.  
3 miles S of Nettleton  
 (distance) (direction) (nearest town)

WELL PURPOSE: Home  
 (home, irrigation, municipal, industrial)


- WELL COMPLETION DATA:
- (1) diameter (inches) 5"
- (2) total depth (feet) 320'
- (3) static water level (feet) 80 below above top of ground.
- (4) casing Steel, 23"  
 (material) (depth)  
 (size) if telescope see back.
- (5) screen -, -  
 (length) (depth to top)  
 (size) (material)
- (6) pump 1/2, 8  
 (HP) (yield gpm)  
 Elec.  
 (type power)
- (7) electric log no  
 (yes or no)  
 (organization running log)
- (8) how well bottom plugged open

CODED

DRILLERS REMARKS:  
 AUG 28 1973

If well telescopes please sketch and show depths.

GROUND LEVEL

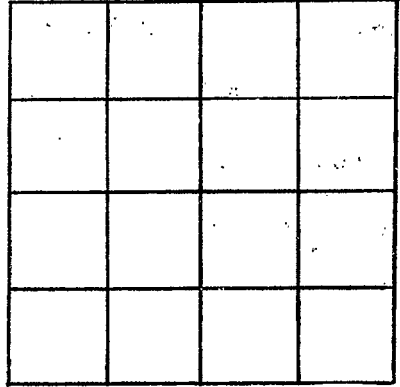

SECTION \_\_\_\_\_

Please indicate well location X.

ADDITIONAL INFORMATION

If more than one screen,  
show locations of each on sketch.