

MONROE
A 69
5-73

MISSISSIPPI
 BOARD OF WATER COMMISSIONERS
 416 North State Street
 Jackson, Mississippi 39201

CODED

WATER WELL DRILLERS LOG

MONROE

May 19 **73** Herndon Well & Supply Company **Lee**
 date well completed firm name county well located

LANDOWNER: Donald Yeager
 (Buddy Snelson, Contractor)
 Nettleton, Miss.
 (mailing address)

description of formations encountered	from	to
	White clay	0
Blue Rock	15	120
Blue Sand	120	280

WELL LOCATION:
 sec. 2 T 12 N R. 6 E
3 miles SW of Nettleton
 (distance) (direction) (nearest town)

WELL PURPOSE: Home
 (home, irrigation, municipal, industrial)

WELL COMPLETION DATA:

- (1) diameter (inches) 5"
- (2) total depth (feet) 280'
- (3) static water level (feet) 80 below ~~static~~ top of ground.
- (4) casing 22' 10", Steel,
 (material) (depth)
 (size) if telescope see back.
- (5) screen 0,
 (length) (depth to top)
 (size) (material)
- (6) pump 1/2, 8
 (HP) (yield gpm)
Elec.
 (type power)
- (7) electric log no
 (yes or no)
 (organization running log)
- (8) how well bottom plugged Open


CODED

DRILLERS REMARKS:

APR 28 1973

If well telescopes please sketch and show depths.

GROUND LEVEL

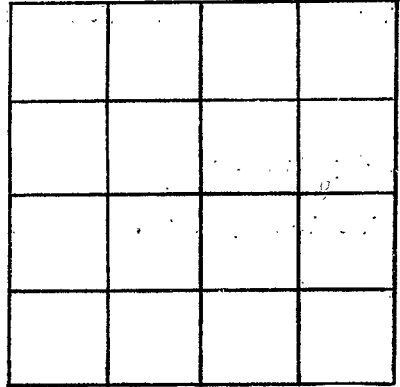

SECTION _____

Please indicate well location X.

ADDITIONAL INFORMATION

If more than one screen,
show locations of each on sketch.