

MONROE
A 70
9-3-73

MISSISSIPPI
BOARD OF WATER COMMISSIONERS
416 North State Street
Jackson, Mississippi 39201

WATER WELL DRILLERS LOG

CODED

Sept 3
date well completed

1975 Herman Homan Well & Supply, Inc.
P.O. Box 42
SHANNON, MISSISSIPPI 38668

Monroe
county well located

LANDOWNER:
Limmie Osborn
Rt 1, Osborn, Miss.
(mailing address)

description of formations encountered	from	to
Surface sand & clay	0	25
Blue clay	25	260
Sand	260	900
Both	900	

WELL LOCATION:
sec. 17 T. 12 N. R. 6 E.
3 1/2 miles SW of Nettleton
(distance) (direction) (nearest town)

WELL PURPOSE: Home
(home, irrigation, municipal, industrial)

- WELL COMPLETION DATA:
- (1) diameter (inches) 5 1/4
 - (2) total depth (feet) 425'
 - (3) static water level (feet) 165' below top of ground
 - (4) casing Steel, 30', (material) (depth)
8" (size) if telescope see back.
 - (5) screen rd, (length) (depth to top)
(size) (material)
 - (6) pump 3/4 HP, 60 (type power) (yield gpm)
 - (7) electric log rd (yes or no)
 - (organization running log)
 - (8) how well bottom plugged open

CODED


OCT 18 1973

DRILLERS REMARKS:

MISS. BD. OF
WATER COMMISSIONERS

If well telescopes please sketch and show depths.

GROUND LEVEL

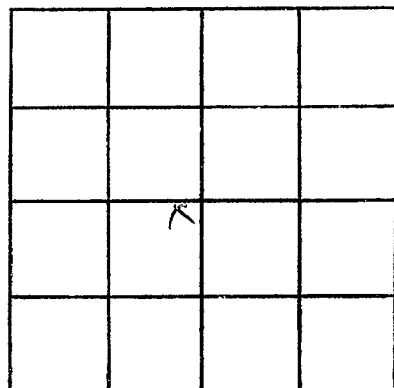

SECTION 17

Please indicate well location X.

ADDITIONAL INFORMATION

If more than one screen,
show locations of each on sketch.