

MONROE

A 71

7-3-74

MISSISSIPPI BOARD OF WATER COMMISSIONERS  
416 North State Street  
Jackson, Mississippi 39201

CODED

WATER WELL DRILLERS LOG

7/3  
date well completed

19 74

Herman Homan Well & Supply, Inc.

firm number SHANNON, MISSISSIPPI 38468

MONROE  
county well located

LANDOWNER:

James Edwards

P.O. Okolona, Miss.  
(mailing address)

description of formations encountered

Surface sand & clay  
White clay  
Sand  
Bottom

from to

0 16  
16 180  
180 320  
320

WELL LOCATION:

sec. 36 T 12 N R 6 E  
S W

1 miles NW of Wren  
(distance) (direction) (nearest town)

WELL PURPOSE:

(home, irrigation, municipal, industrial)

WELL COMPLETION DATA:

- (1) diameter (inches) 5 1/2
- (2) total depth (feet) 320
- (3) static water level (feet) 120 below top of ground
- (4) casing (material) steel (depth) 21'
- 5 1/2 (size) if telescope see back.
- (5) screen (length) 10 (depth to top)
- (size) (material)
- (6) pump (HR) 5 (yield gpm)
- electric (type power)
- (7) electric log (yes or no)

(organization running log)

(8) how well bottom plugged 3/4

DRILLERS REMARKS:


CODED

RECEIVED  
AUG - 8 1974

MISS. BD. OF WATER COMM.

If well telescopes please sketch and show depths.

GROUND LEVEL

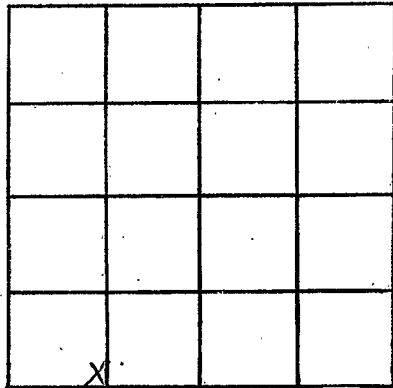

SECTION 36

Please indicate well location X.

ADDITIONAL INFORMATION

If more than one screen, show locations of each on sketch.