

MONROE
 A72
 6-25-74

MISSISSIPPI
 BOARD OF WATER COMMISSIONERS
 416 North State Street
 Jackson, Mississippi 39201

CODED

WATER WELL DRILLERS LOG

Herman Homan Well & Supply, Inc.¹

8-25 1974
 date well completed

SHANNON, MISSISSIPPI 38868

Monroe
 county well located

LANDOWNER:	description of formations encountered	from	to
Kattie Cox	Surface sand +		
Rt 2 Nettleton Miss (mailing address)	Clay	0	16
	Blue clay	16	160
	Sand	160	280
	Bottom	280	
WELL LOCATION:			
sec. 3 T 12 N R 6 E S W			
1 miles SW of Nettleton (distance) (direction) (nearest town)			
WELL PURPOSE: Home (home, irrigation, municipal, industrial)			
WELL COMPLETION DATA:			
(1) diameter (inches) 5"			
(2) total depth (feet) 280'			
(3) static water level (feet) 81' below top of ground			
(4) casing steel 21' 5" (material) (depth)			
5 (size) if telescope see back.			
(5) screen 10 (length) (depth to top)			
(size) (material)			
(6) pump 1/2 (HP) 5 (yield gpm)			
electr (type power)			
(7) electric log NO (yes or no)			
(organization running log)			
(8) how well bottom plugged open			
DRILLERS REMARKS:			


CODED

RECEIVED
 AUG - 8 1974

MISS. BD. OF WATER COMMISSIONERS

If well telescopes please sketch and show depths.

GROUND LEVEL

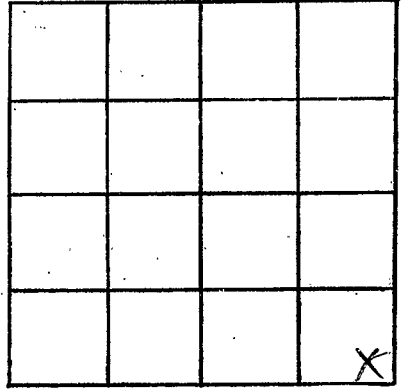

SECTION 3

Please indicate well location X.

ADDITIONAL INFORMATION

If more than one screen, show locations of each on sketch.