

Monroe
A 73
7-24-75

MISSISSIPPI
BOARD OF WATER COMMISSIONERS CODED
416 North State Street
Jackson, Mississippi 39201

WATER WELL DRILLERS LOG

7/28/75 date well completed
1975
Herman Homan Well & Supply, Inc.
firm name
QUANNON MISSISSIPPI 38868
Monroe county well located

LANDOWNER:	description of formations encountered	from	to
Jewel McIntosh	surface sand	0	18
at Okolona, Miss	clay	18	260
(mailing address)	blue clay	260	400
	sand	400	
	bottom	400	

WELL LOCATION:
sec. 17 T. 12 N. R. 6 E. 13C
3 miles S.W. of Nettles
(distance) (direction) (nearest town)

WELL PURPOSE: Home
(home, irrigation, municipal, industrial)


- WELL COMPLETION DATA:
- (1) diameter (inches) 4"
 - (2) total depth (feet) 400'
 - (3) static water level (feet) 170' below top of ground.
 - (4) casing steel, 2 1/2" (material) (depth)
4' (size) If telescope see back.
 - (5) screen 20 (length) (depth to top)
(size) (material)
 - (6) pump 3/4 5 (HP) (yield gpm)
electr (type power)
 - (7) electric log No (yes or no)
(organization running log)
 - (8) how well bottom plugged open

DRILLERS REMARKS:

RECORDED
INDEXED
AUG 18 1975
MISS. DEPT. OF WATER CONTROL

If well telescopes please sketch and show depths.

GROUND LEVEL

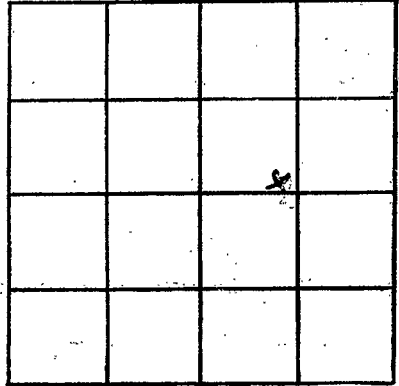

SECTION 17

Please indicate well location X.

ADDITIONAL INFORMATION

If more than one screen,
show locations of each on sketch.