

MONROE
A-74
8/10/80

MISSISSIPPI
 BOARD OF WATER COMMISSIONERS
 416 North State Street
 Jackson, Mississippi 39201

CODED

WATER WELL DRILLERS LOG

Bumer Drilling Service, Inc.

Monroe

date well completed

firm name

county well located

LANDOWNER:
Betty Oil Corporation
P.O. Box 10898
Mobile, Ala 36616
 (mailing address)

description of formations encountered	from	to
<u>Chalk</u>	<u>0</u>	<u>21</u>
<u>Chalk & rock</u>	<u>21</u>	<u>105</u>

WELL LOCATION: 220° S + 1250' W
no 1 in 4 T 12 N R 6 of
Schleiss W NE/COF
4-8 Nettleton
 (distance) (direction) (nearest town)

<u>Shell</u>	<u>105</u>	<u>112</u>
<u>chalk</u>	<u>112</u>	<u>126</u>

WELL PURPOSE: all fields supply
 (home, irrigation, municipal, industrial)

<u>sand</u>	<u>126</u>	<u>150</u>
-------------	------------	------------

WELL COMPLETION DATA:
 (1) diameter (inches) 3"
 (2) total depth (feet) 294'
 (3) static water level (feet) 75' below above
 top of ground.
 (4) casing steel, 294'
 (material) (depth)
3"
 (size) if telescope see back.
 (5) screen 42', 252'
 (length) (depth to top)
3", perforated
 (size) (material)
 (6) pump 75
 (HP) (yield gpm)
ac
 (type power)
 (7) electric log —
 (yes or no)
 (organization running log)

<u>chalk</u>	<u>150</u>	<u>170</u>
<u>chalk & sand</u>	<u>170</u>	<u>220</u>
<u>sand</u>	<u>220</u>	<u>294</u>

(8) how well bottom plugged orange
peel

DRILLERS REMARKS:


DEPT. OF NATURAL RESOURCES
 BUREAU OF LAND & WATER RESOURCES

AUG 27 1980

RECEIVED

If well telescopes please sketch and show depths.

GROUND LEVEL

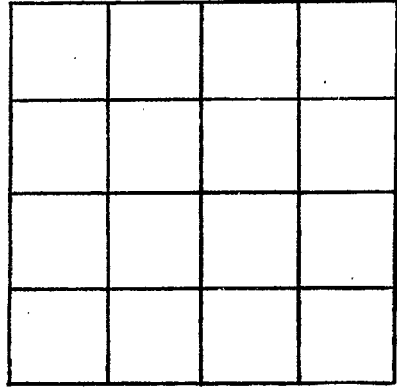

SECTION _____

Please indicate well location X.

ADDITIONAL INFORMATION

If more than one screen, show locations of each on sketch.