

MISSISSIPPI DEPARTMENT OF NATURAL RESOURCES

Bureau of Land and Water Resources

Southport Mall

P.O. Box 10631

CODED

Jackson, Mississippi 39209

WATER WELL DRILLERS LOG *Monroe*

Griner Drilling Service, Inc.

Clay

MONROE
A 75
4-11-81

date well completed

firm name

county well located

LANDOWNER:

Getty Oil Corporation
P.O. Box 16809
Mobile, Alabama 36616
(mailing address)

description of formations encountered

from

to

rock, clay

0 189

sand

189 273

streaked clay

273 378

WELL LOCATION:

1500' N + 1600' E

No. 1 Stovall
3-11
3-11 miles (distance) *N* (direction) *6* miles (nearest town) *of W. Swilcor*
Nettleton Field

WELL PURPOSE:

oil field supply
(home, irrigation, manufacturing, industrial)

WELL COMPLETION DATA:

(1) diameter (inches) *3"*

(2) total depth (feet) *378'*

(3) static water level (feet) *80'* *below* top of ground.

(4) casing *steel*, *223'*
(material) (depth)

3"
(size) if telescope see back.

(5) screen *42'*, *231'*
(length) (depth to top)

3", *perforated*
(size) (material)

(6) pump *60*
(HP) (yield gpm)


PC
(type power)

(7) electric log _____
(yes or no)

(organization running log)


(8) how well bottom plugged *orange*
peel

DRILLERS REMARKS:

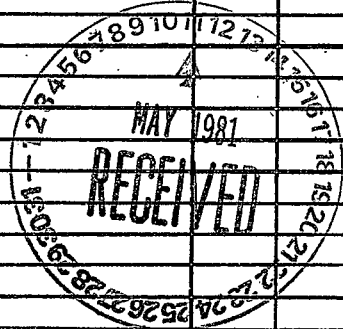

If well telescopes please sketch and show depths.

GROUND LEVEL

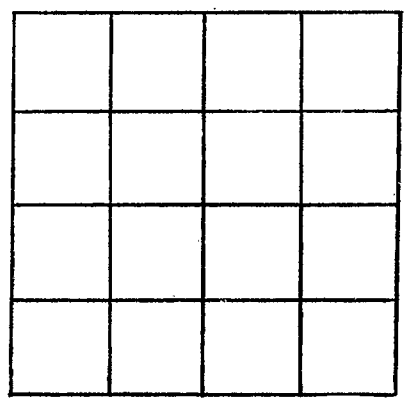

SECTION _____

Please indicate well location X.

ADDITIONAL INFORMATION

A series of horizontal lines for entering additional information.

If more than one screen, show locations of each on sketch.