

05/22/2006 10:31 5624562284

PARKS & PARKS WATER

PAGE 02

COUNTY WELL LOCATED
MONROE

WELL NUMBER CODED
A-80

DATE WELL COMPLETED
MARCH 2004

PERMIT NUMBER
OW16310

NAME OF DRILLING FIRM
PARKS & PARKS WELL SERVICES

MISSISSIPPI DEPARTMENT OF ENVIRONMENTAL QUALITY
Office of Land and Water Resources

P. O. Box 10631
Jackson, MS 39289-0631
WATER WELL DRILLERS LOG

NAME & MAILING ADDRESS OF LANDOWNER
**WREN WATER DIST
32657 HWY 45 NORTH
ABERDEEN MS 39130**

Latitude:
Longitude:

WELL LOCATION. SEC TOWNSHIP RANGE
35 12 N 6 E

DISTANCE DIRECTION NEAREST TOWN

OTHER LANDMARK

WELL PURPOSE: Home, Irrigation, Municipal, Industrial, Fish Pond, etc.
WATER SYSTEM

PUMP DATA

PUMP TYPE (Circle One):
Submersible, Turbine Jet Flowing Well,
Other (Describe)

POWER TYPE (Circle One):
Electric Tractor, Diesel, Gasoline, Butane,
Other (Describe) H/P

DESCRIPTION OF FORMATIONS ENCOUNTERED	FROM	TO
Top Soil	0	5
Clay	5	120
SAND	110	240
Clay	240	255
SAND	255	360
Clay	360	120

WELL DATA

Well Depth Casing Diameter (in.) Casing Length (ft.)
360 12 285

Type of Casing Hole Depth Depth to Static Water Level
STEEL 420 123

TYPE OF COMPLETION: (Circle One or More):
Gravel Packed, Underreamed, Telescoped,
Natural Development, Open Hole, Other
(Describe)

WELL GROUTED TO A DEPTH OF **285** FEET
Type Grout (circle one): Cement, Bentonite, or Mix

SCREEN DATA

Diameter - inches Length - Feet Slot Size - inches
6 75 1020

Screen Type Depth to Bottom - Feet
STAINLESS STEEL 360

Top of Lap Pipe or Reduction in Casing
230 FEET IF TELESCOPED OR MORE THAN ONE SCREEN: USE BACK PAGE

I certify that the well was drilled, constructed and completed in accordance with all applicable Requirements of the Mississippi Department of Environmental Quality and/or the Mississippi Department of Health regulations and state laws.


[Signature]
Signature of Licensed Driller and License No. **0-414**

3/22/05
Date

Additional Information Required On Back

GW16310

If well telescopes please sketch and show depths.

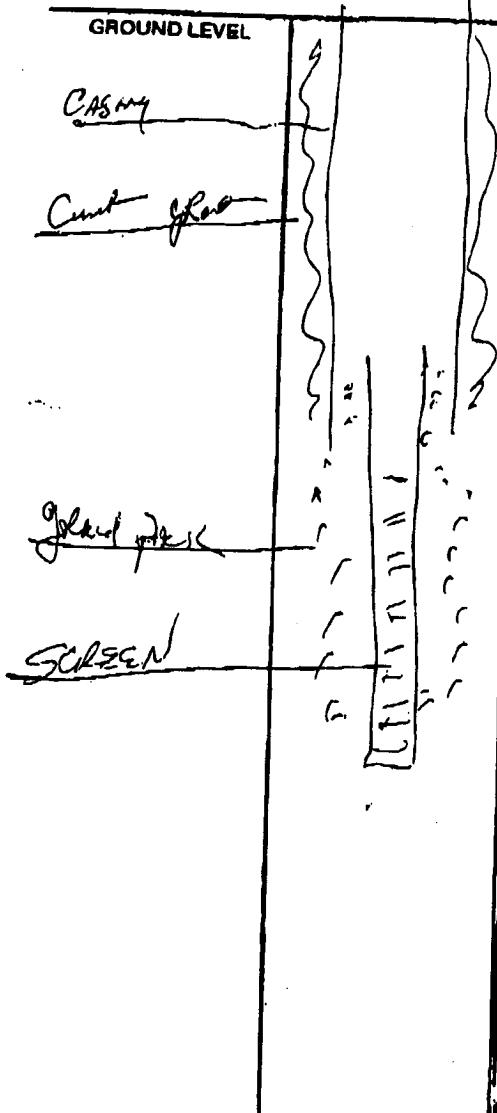

A-80

SECTION _____

Please indicate well location X.

Pump Capacity (GPM)	No. of Stages	Setting Depth	
275	7	210	FT.

PUMP TEST

Well yielded _____ GPM with a drawdown of _____ ft. after _____ hours of pumping

LOG DATA

TYPE OF LOG RUN (Circle One): Electric, Gamma Ray, Density, Sonic, Neutron, No Log Run, Other (Describe) MSGS

Name of Organization Running Log _____

GEOLOGIC DATA (Office Use Only)

Surface Elev.	Geologic Unit	UNIT THICKNESS	Depth to Top
Subs. DWL	Date	Analysis	Aquifer Test

Driller's Remarks

If more than one screen, show location of each on sketch.

MISSISSIPPI DEPARTMENT OF ENVIRONMENTAL QUALITY
Office of Land and Water Resources

P. O. Box 10631
Jackson, MS 39289-0631
WATER WELL DRILLERS LOG

3/28/03
you
AP

COUNTY WELL LOCATED Monroe		PERMIT NUMBER OW 16310	
WELL NUMBER 6	CODED	NAME OF DRILLING FIRM PARKS & PARKS WELL SERVICES	
DATE WELL COMPLETED March 2003			
NAME & MAILING ADDRESS OF LANDOWNER WREN WATER DIST 32657 HWY 45 NORTH ABERDEEN MS 39130			
Latitude: Longitude:			
WELL LOCATION, SEC TOWNSHIP RANGE 35 12 N 6 E			
DISTANCE DIRECTION NEAREST TOWN			
OTHER LANDMARK			
WELL PURPOSE: Home, Irrigation, Municipal, Industrial, Fish Pond, etc. WATER SYSTEM			
WELL DATA			
Well Depth 360	Casing Diameter (in.) 12	Casing Length (ft.) 285	
Type of Casing STEEL	Hole Depth 420	Depth to Static Water Level 123	
TYPE OF COMPLETION: (Circle One or More): <input checked="" type="checkbox"/> Gravel Packed, <input type="checkbox"/> Underreamed, <input type="checkbox"/> Telescoped, <input type="checkbox"/> Natural Development, <input type="checkbox"/> Open Hole, <input type="checkbox"/> Other (Describe)			
WELL GROUTED TO A DEPTH OF 285 FEET Type Grout (circle one): <input checked="" type="checkbox"/> Cement, <input type="checkbox"/> Bentonite, or <input type="checkbox"/> Mix			
SCREEN DATA			
Diameter - inches 6	Length - Feet 75	Slot Size - inches 1020	
Screen Type STAINLESS STEEL		Depth to Bottom - Feet 360	
Top of Lap Pipe or Reduction in Casing 230 FEET IF TELESCOPED OR MORE THAN ONE SCREEN: USE BACK PAGE			
<p>I certify that the well was drilled, constructed and completed in accordance with all applicable Requirements of the Mississippi Department of Environmental Quality and/or the Mississippi Department of Health regulations and state laws.</p> <p><i>[Signature]</i> 0-414 Signature of Licensed Driller and License No.</p> <p><u>3/28/03</u> Date</p>			

Additional Information Required On Back