

MA 2001  
2-11-61

WATER WELL DRILLERS LOG

Herndon Well & Supply Co.  
SHANNON, MISS.

Date: 2/11, 1961, Driller: \_\_\_\_\_ County: Harrison

(Name)

(1) Owner of Land: Wardell Gore  
(Name)  
RR 1 SHANNON, MISS.  
(Address)

(2) Location: \_\_\_\_\_ 1/4, \_\_\_\_\_ 1/4, Sec. 31 T. 15 S. R. 5 E  
1 1/2 miles South, of Shannon  
(distance) (direction) (Nearest Town)

(3) Topography: Flat  
(Hilly) (Flat) (Level)

(4) Purpose of Well: Home use  
(Domestic Irrigation  
Municipal, Industrial, Other)

Description & Color of Materials Sand, Clay, Red Clay, Shell, etc.	Thick- ness Feet	Depth Feet
<u>Clay</u>		<u>18</u>
<u>Blue Rock</u>		
<u>Sand</u>	<u>24</u>	
<u>Bottom</u>		<u>370</u>

Information upon completion of well:

(1) Diameter 4 inches.

(2) Total Depth 370 feet.

(3) Water Level 40 feet below top of ground.


(4) Cased to 22' 11", Size 4"

(5) Screen: Size \_\_\_\_\_, Length \_\_\_\_\_

(6) Were any formations sealed against pollution?  
X yes, \_\_\_\_\_ no.

If YES depth of formation 16 ft.  
Why Sustained & Sealed

Drillers Remarks: \_\_\_\_\_

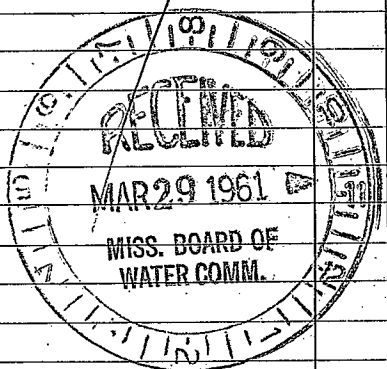

(Use Back Side)

Well No.

