

MONROE

MISSISSIPPI BOARD OF WATER COMMISSIONERS

A 2002

6-28-62

WATER WELL DRILLERS LOG

Date: Jun 26, 1962, Driller: MONROE WELL & SUPPLY CO. County: Monroe

(Name)


MONROE, MISSISSIPPI

	Description & Color of Materials Sand, Clay, Red Clay, Shell, etc.	Thick- ness Feet	Depth Feet
(1) Owner of Land: <u>C.A. Topscott</u> 963 2126 (Name) <u>Nettleton, Miss</u> (Address)	Surface sand & clay		0
(2) Location: $\frac{1}{4}$ , $\frac{1}{4}$ , Sec. 1 T <sup>12S</sup> R <sup>6E</sup>  _____ miles _____ of <u>Nettleton</u> (distance) (direction) (Nearest Town)	Blue water sand	23	23
(3) Topography: <u>Flat</u> (Hilly) (Flat) (Level)	Bottom	180	180
(4) Purpose of Well: <u>Domestic</u> (Domestic Irrigation Municipal, Industrial, Other)			

Information upon completion of well:

- (1) Diameter 4 inches.
- (2) Total Depth 180 feet.
- (3) Water Level 40 feet below top of ground.
- (4) Cased to 25' 10", Size 4"
- (5) Screen: Size \_\_\_\_\_, Length \_\_\_\_\_
- (6) Were any formations sealed against pollution?  
 yes,  no.

If YES depth of formation 23 ft.  
Why Surface & sand  
Drillers Remarks: \_\_\_\_\_

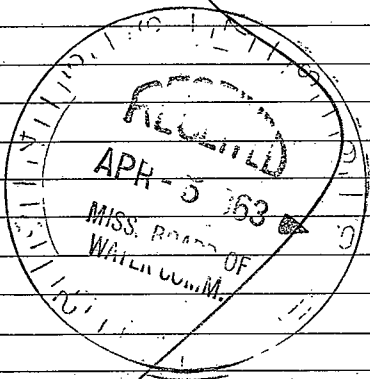

(Use Back Side)

Well No.

