

A 2004
6-8-61

WATER WELL DRILLERS LOG

A303

HERNDON WELL & SUPPLY CO.

Date: June 8, 1961, Driller: _____ P. O. BOX 42 County Monroe
SHANNON, MISSISSIPPI

(1) Owner of Land: Fred Martin
(Name)
Okolona, Miss.
(Address)

(2) Location: 1/4, 1/4, Sec 26 T 125 R 6E
_____ miles South of Nottingham
(distance) (direction) (Nearest Town)

(3) Topography: Flat
(Hilly) (Flat) (Level)

(4) Purpose of Well: Domestic
(Domestic Irrigation
Municipal, Industrial, Other)

Description & Color of Materials Sand, Clay, Red Clay, Shell, etc.	Thick- ness Feet	Depth Feet
Surface sand & clay		0
Blue rock		29
sand		140
Bottom		260

Information upon completion of well:

(1) Diameter 4 inches.

(2) Total Depth 260 feet.

(3) Water Level 120 feet below top of ground.

(4) Cased to 33' 6", Size 4".


(5) Screen: Size _____, Length _____.

(6) Were any formations sealed against pollution?
 yes, _____ no.

If YES depth of formation 29'

Why Surface & Sand

Drillers Remarks: _____

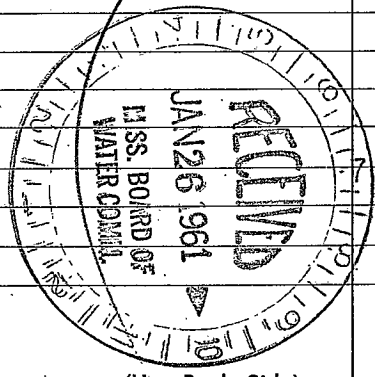

(Use Back Side)

Well No.

