

MON ROE

MISSISSIPPI BOARD OF WATER COMMISSIONERS

WATER WELL DRILLERS LOG

A305

A 2005
6-22-61

Date June 22 1961 Driller: HERNDON WELL & SUPPLY CO County Madison

P.O. BOX 42
SHANNON, MISSISSIPPI

(1) Owner of Land: C.D. Topush
(Name)
Nettles Miss.
(Address)

(2) Location: 1/4, 1/4, Sec. 31 T115 R6E
1 miles South, of Nettles
(distance) (direction) (Nearest Town)

(3) Topography: Flat
(Hilly) (Flat) (Level)

(4) Purpose of Well: Domestic
(Domestic Irrigation
Municipal, Industrial, Other)

Description & Color of Materials Sand, Clay, Red Clay, Shell, etc.	Thick- ness Feet	Depth Feet
<u>Subsided sand</u>		0
<u>& clay</u>		
<u>Blue rock</u>		20
<u>&</u>		
<u>Sand</u>		80
<u>&</u>		
<u>Bottom</u>		180

Information upon completion of well:

(1) Diameter 4 inches.

(2) Total Depth 180 feet.

(3) Water Level 60 feet below top of ground.

(4) Cased to 24' 9", Size 4"


(5) Screen: Size , Length

(6) Were any formations sealed against pollution?
✓ yes, no.

If YES depth of formation 20 ft

Why Subsided & Sand

Drillers Remarks:

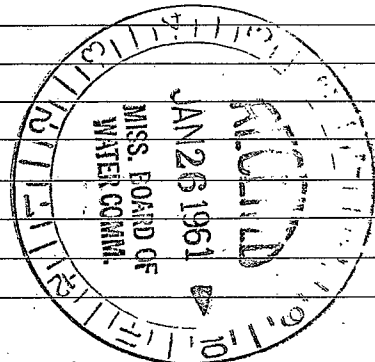

(Use Back Side)

Well No.

