

WATER WELL DRILLERS LOG

BA
6-16-62 2006

Date: June 16, 1962 Driller: HERNDON WELL & SUPPLY CO. County: Monroe

P.O. BOX 42
SHANNON, MISSISSIPPI

MOLLY MCINTOSH

(1) Owner of Land: Fred Martin
(Name)

Rt 1 Okolona, Miss
(Address)

(2) Location: $\frac{1}{4}$, $\frac{1}{4}$, Sec. 36 125
North West
2 miles South of Ward
(distance) (direction) (Nearest Town)

(3) Topography: Flat
(Hilly) (Flat) (Level)

(4) Purpose of Well: Domestic
(Domestic Irrigation
Municipal, Industrial, Other)

Description & Color of Materials Sand, Clay, Red Clay, Shell, etc.	Thick- ness Feet	Depth Feet
<u>Surface sand</u>		<u>0</u>
<u>& clay</u>		
<u>Blue sand</u>		<u>28</u>
<u>Sand</u>		<u>140</u>
<u>Bottom</u>		<u>260</u>

Information upon completion of well:

(1) Diameter 4 inches.

(2) Total Depth 260 feet.

(3) Water Level 90 feet below top of ground.

(4) Cased to 31' 8" Size 44


(5) Screen: Size _____, Length _____

(6) Were any formations sealed against pollution?
 yes, _____ no.

If YES depth of formation 28 ft.

Why surface & sand

Drillers Remarks:

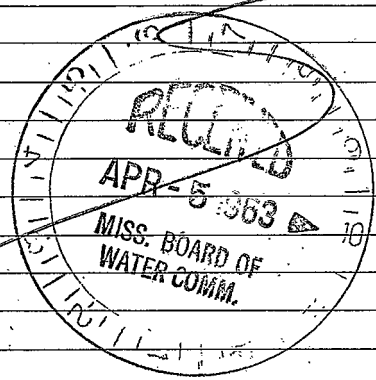

(Use Back Side)

Well No.

