

MONROE

A 7067

1-22-63

WATER WELL DRILLERS LOG

HERNDON WELL & SUPPLY CO.

Date: Jan 22, 1963, Driller: P. O. BOX 42 County Monroe
SHANNON, MISSISSIPPI

RIC Tree Corp 4th no accept

(1) Owner of Land: B. G. Cogges
 9632350 (Name)
Hettler Miss
 (Address)

(2) Location: 1/4, 1/4, Sec 23 T 12 S R 6 E
4 miles South of Hettler
 (distance) (direction) (Nearest Town)

(3) Topography: Flat
 (Hilly) (Flat) (Level)

(4) Purpose of Well: Domestic
 (Domestic Irrigation
 Municipal, Industrial, Other)

Description & Color of Materials Sand, Clay, Red Clay, Shell, etc.	Thick- ness Feet	Depth Feet
<u>surface sand</u>		<u>0</u>
<u>& clay</u>		
<u>to</u>		
<u>Blue sand</u>		<u>90</u>
<u>to</u>		
<u>sand</u>		<u>200</u>
<u>to</u>		
<u>Bottom</u>		<u>320</u>

Information upon completion of well:

(1) Diameter 4 inches.

(2) Total Depth 320 feet.

(3) Water Level 132 feet below top of ground.

(4) Cased to 53', Size 4"


(5) Screen: Size —, Length —

(6) Were any formations sealed against pollution?
 yes, no.

If YES depth of formation 50 ft

Why surface & sand

Drillers Remarks:

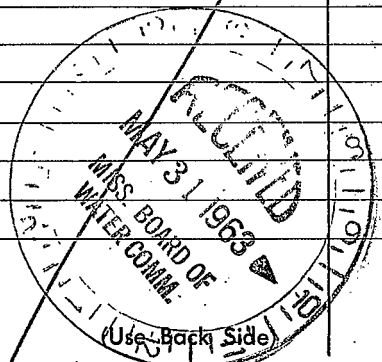

Well No.

