

A 2008
6-7-63

WATER WELL DRILLERS LOG

Date: 6-7, 1963, Driller: HERNDON WELL & SUPPLY CO.
 P. O. BOX 42 County Monroe
 SHANNON, MISSISSIPPI

(1) Owner of Land: Lalain Clayton
 (Name)
At 3 Aberdeen, Miss.
 (Address)
 (2) Location: 1/4, 1/4, Sec. 25 T 123 R 11
4 miles S of Nettleton
 (distance) (direction) (Nearest Town)
 (3) Topography: Flat
 (Hilly) (Flat) (Level)
 (4) Purpose of Well: Domestic
 (Domestic Irrigation
 Municipal, Industrial, Other)

Description & Color of Materials
 Sand, Clay, Red Clay, Shell, etc.

Thick-
ness
Feet

Depth
Feet

surface sand 0
& clay
Blue sand 24
to
sand
to 150
Bottom 300


Information upon completion of well:

(1) Diameter 4 inches.
 (2) Total Depth 300 feet.
 (3) Water Level 120 feet below top of ground.
 (4) Cased to 30', Size 4"
 (5) Screen: Size —, Length —
 (6) Were any formations sealed against pollution?
✓ yes, — no.

If YES depth of formation 24'

Why surface & sand

Drillers Remarks:

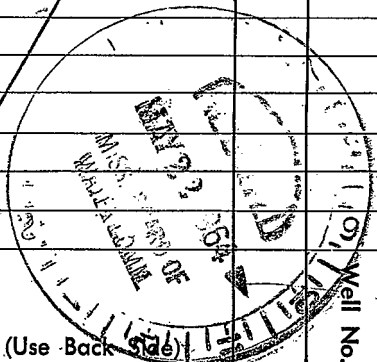

(Use Back Side)

