

MEATROE

DA 2009
7-8-63

WATER WELL DRILLERS LOG

Date: 7/8, 1963, Driller: HERNDON WELL & SUPPLY CO. P.O. BOX 42 County Monroe
SHANNON, MISSISSIPPI

(1) Owner of Land United Corce
(Name)
At Thomas, Miss.
(Address)

(2) Location: 3/4, 1/4, Sec 31 T 11 R 6E
2 miles S, of Thomas
(distance) (direction) (Nearest Town)

(3) Topography: flat
(Hilly) (Flat) (Level)

(4) Purpose of Well: Domestic
(Domestic Irrigation
Municipal, Industrial, Other)

Description & Color of Materials Sand, Clay, Red Clay, Shell, etc.	Thick- ness Feet	Depth Feet
<u>surface sand</u>		<u>0</u>
<u>& clay</u>		
<u>Blue sand</u>		<u>32</u>
<u>sand</u>		<u>220</u>
<u>Bottom</u>		<u>340</u>

Information upon completion of well:

(1) Diameter 4 inches.

(2) Total Depth 340 feet.

(3) Water Level 70 feet below top of ground.

(4) Cased to 34', Size 44.


(5) Screen: Size _____, Length _____.

(6) Were any formations sealed against pollution?
yes, _____ no.

If YES depth of formation 32'

Why surface sand

Drillers Remarks:

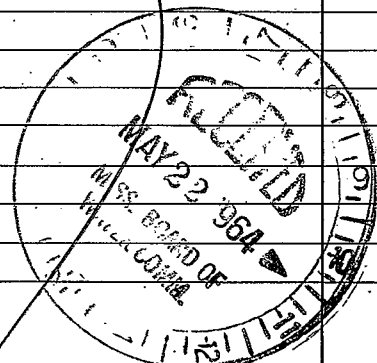

(Use Back Side)

Well No.

