

MONROE MISSISSIPPI BOARD OF WATER COMMISSIONERS

A 2011  
5-3-65

WATER WELL DRILLERS LOG

Herndon-Homan Well & Supply, Inc.

Date: May 3, 1965, Driller: SHANNON, P. O. Box 42, County Monroe, MISSISSIPPI 38868

		Description & Color of Materials. Sand, Clay, Red Clay, Shell, etc.	Thick- ness Feet	Depth Feet
(1) Owner of Land:	<u>R. C. Coggin</u> (Name)			
	<u>Nettleton, Miss</u> (Address)	<u>sand &amp; clay</u>		<u>0-23</u>
		<u>Blue clay</u>		<u>23-160</u>
(2) Location:	<u>1/4, 1/4, Sec 14 T 125 R 65</u>	<u>sand</u>		<u>160-300</u>
	<u>2 1/2 miles S</u> of <u>Nettleton</u> (distance) (direction) (Nearest Town)	<u>Bottom</u>		<u>300</u>
(3) Topography:	<u>Hilly</u> (Hilly) (Flat) (Level)			
(4) Purpose of Well:	<u>Domestic</u> (Domestic Irrigation Municipal, Industrial, Other)			

Information upon completion of well:


- (1) Diameter 6 inches.
- (2) Total Depth 300 feet.
- (3) Water Level 120 feet below top of ground.
- (4) Cased to 25', Size 5"
- (5) Screen: Size     , Length
- (6) Were any formations sealed against pollution?

yes,  no.

If YES depth of formation 23'

Why surface & sand

Drillers Remarks:  
\_\_\_\_\_  
\_\_\_\_\_  
\_\_\_\_\_

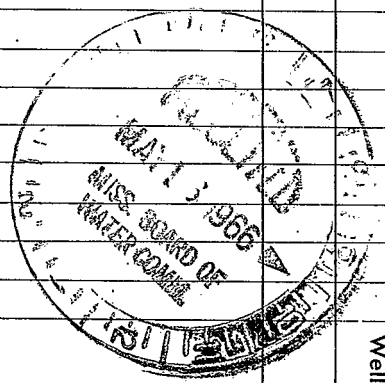

(Use Back Side)

Well No.

Retain this copy for your office files.

