

MONROE
A 2014
11-67

MISSISSIPPI
BOARD OF WATER COMMISSIONERS
416 North State Street
Jackson, Mississippi 39201

WATER WELL DRILLERS LOG

STANDARD

11/30 19 57 Gordon-Homan Well & Supply, Inc. ~~Electra-Sect~~
date well completed firm name
NEXT TO TRAIL, SHANNON, MISSISSIPPI 38860 county well located

LANDOWNER: T.H. HARDAWAY
C.B. Sullivan (owner)
Hollway, Rt 1 Okolona
(mailing address) MISS


description of formations encountered	from	to
surface clay	0	20
blue clay	20	180
sand	180	300
bottom	300	

WELL LOCATION:
15 sec. 33 T 1 N R6 E
S 4 W
2 1/2 miles NW of Wood
(distance) (direction) (nearest town)

WELL PURPOSE: Home
(home, irrigation, municipal, industrial)

WELL COMPLETION DATA:

- (1) diameter (inches) 4"
- (2) total depth (feet) 300'
- (3) static water level (feet) 75' below top of ground
- (4) casing Steel, 22"
(material) (depth)
If telescope see back.
(size)
- (5) screen none
(length) (depth to top)
(size) (material)
- (6) pump 3/4 5
(HP) (yield gpm)
electra
(type power)
- (7) electric log No
(yes or no)
(organization running log)
- (8) how well bottom plugged open

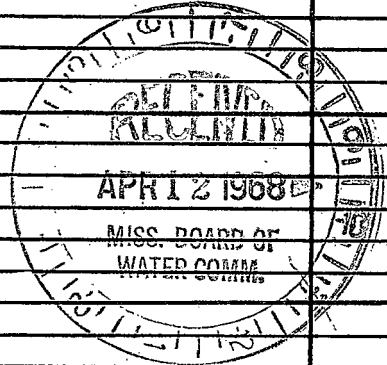

DRILLERS REMARKS:

If well telescopes please sketch and show depths.

GROUND LEVEL

SECTION _____

Please indicate well location X.

ADDITIONAL INFORMATION

If more than one screen, show locations of each on sketch.