

MONROE
A 2015
12-67

MISSISSIPPI
BOARD OF WATER COMMISSIONERS
416 North State Street
Jackson, Mississippi 39201

WATER WELL DRILLERS LOG

12/12/67 Herndon-Roman Well & Supply, Inc. Monroe
date well completed firm name Box 42 county well located
OSHTON, MISSISSIPPI 38868

LANDOWNER:
EAST RATLIFF
AT: OGDONA, MISS.
(mailing address)

description of formations encountered	from	to
surface sand clay	0	20
Blue clay	20	300
Sand	300	420
Bottom	420	

WELL LOCATION:
sec. 6 T 12 N R 6 E
S W
4 miles NE of Ogdona
(distance) (direction) (nearest town)

WELL PURPOSE: Home
(home, irrigation, municipal, industrial)

WELL COMPLETION DATA:

(1) diameter (inches) 5"

(2) total depth (feet) 420

(3) static water level (feet) 136' below top of ground.


(4) casing Steel, 22' 10"
(material) (depth)
if telescope see back.
(size)

(5) screen none
(length) (depth to top)
(size) (material)

(6) pump 1/2 5
(HP) (yield gpm)
electric
(type power)

(7) electric log no
(yes or no)
(organization running log)

(8) how well bottom plugged open

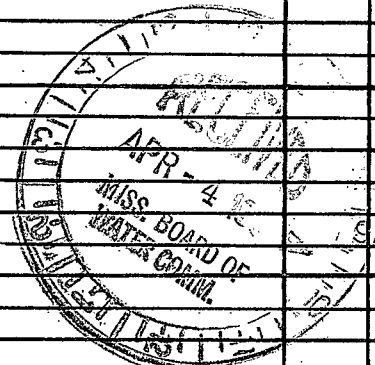

DRILLERS REMARKS:

If well telescopes please sketch and show depths.

GROUND LEVEL

SECCIÓN _____

Please indicate well location X.

ADDITIONAL INFORMATION

If more than one screen,
show locations of each on sketch.