

**MONROE**  
**A 2017**  
**5-21-76**

**MISSISSIPPI**  
**BOARD OF WATER COMMISSIONERS**  
 416 North State Street  
 Jackson, Mississippi 39201

**WATER WELL DRILLERS LOG**

Herman Homan Well & Supply, Inc.  
 P. O. Box 42  
 SHANNON, MISSISSIPPI 38860

*Monroe*

5-21-76  
 date well completed


county well located

LANDOWNER:	description of formations encountered	from	to
James Jones Rt 1, Shannon MS, (mailing address)	Surface sand + clay Blue clay 5 mud B.H.	0	16 200 300 340
<b>WELL LOCATION:</b> sec. <u>7</u> T. <u>12</u> N. R. <u>6</u> E. S. <u>5</u> 5 miles S.W. of <u>Wethers</u> (distance) (direction) (nearest town)			
<b>WELL PURPOSE:</b> Home (home, irrigation, municipal, industrial)			
<b>WELL COMPLETION DATA:</b> (1) diameter (inches) <u>4 1/2</u> (2) total depth (feet) <u>340'</u> (3) static water level (feet) <u>81'</u> below above top of ground. (4) casing <u>Steel</u> , <u>20'</u> (material) (depth) <u>4 1/2"</u> if telescope see back. (size) (5) screen <u>no</u> (length) (depth to top) (size) (material) (6) pump <u>1/2</u> <u>5</u> (HP) (yield gpm) <u>electric</u> (type power) (7) electric log <u>NO</u> (yes or no) (organization running log) (8) how well bottom plugged <u>Open</u>			
<b>DRILLERS REMARKS:</b>			

JUL 1 1976  
 MISS. Bd. OF WATER COMMISSIONERS

If well telescopes please sketch and show depths.

GROUND LEVEL

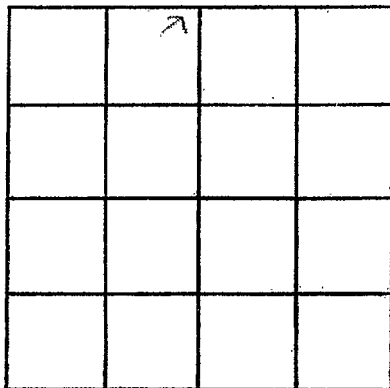

SECTION 7

Please indicate well location X.

ADDITIONAL INFORMATION

If more than one screen,  
show locations of each on sketch.