

MONROE
A 2018
4-25-77

MISSISSIPPI
 BOARD OF WATER COMMISSIONERS
 416 North State Street
 Jackson, Mississippi 39201

13C

WATER WELL DRILLERS LOG

Herman Homan Well & Supply, Inc.

P.O. Box 42

SHANNON, MISSISSIPPI 38868

Monroe
 county well located

4-25
 date well completed

1977

LANDOWNER:	description of formations encountered	from	to
<u>Elmer Gladney</u> <u>PO 2 Natchitoches MS</u> (mailing address)	<u>Surface sand</u> <u>clay</u> <u>blue clay</u> <u>sand</u> <u>beds</u>	<u>0</u> <u>16</u> <u>150</u> <u>280</u>	<u>16</u> <u>150</u> <u>280</u>
WELL LOCATION: sec. <u>3</u> T. <u>12</u> N. R. <u>6</u> E. <u>2</u> miles <u>SW</u> of <u>Natchitoches</u> (distance) (direction) (nearest town)			
WELL PURPOSE: <u>Home</u> (home, irrigation, municipal, industrial)			
WELL COMPLETION DATA: (1) diameter (inches) <u>4 1/2</u> (2) total depth (feet) <u>280</u> (3) static water level (feet) <u>0</u> below above top of ground (4) casing <u>Steel</u> , <u>2 1/2"</u> (material) (depth) <u>4 1/2"</u> If telescope see back. (size) (5) screen <u>40</u> , (length) (depth to top) (size) (material) (6) pump <u>1/2</u> <u>5</u> (HP) (yield gpm) <u>electric</u> (type power) (7) electric log <u>no</u> (yes or no) (organization running log) (8) how well bottom plugged <u>Open</u>			
DRILLERS REMARKS:			


RECEIVED

JUN 1 1977

MISS. BD. OF WATER COMMISSIONERS

If well telescopes please sketch and show depths.

GROUND LEVEL

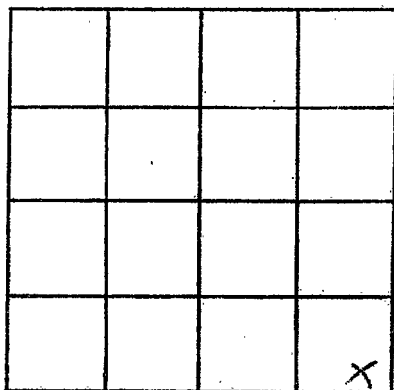

SECTION 3

Please indicate well location X.

ADDITIONAL INFORMATION

If more than one screen,
show locations of each on sketch.