

MONROE
A 2019
10-2-78

**MISSISSIPPI
BOARD OF WATER COMMISSIONERS**
416 North State Street
Jackson, Mississippi 39201

WATER WELL DRILLERS LOG

Herman Homan Well & Supply, Inc.
P. O. Box 42

10/2 1978 date well completed SHANNON, MISSISSIPPI 38668 Monroe county well located

LANDOWNER:
Frederick Jones
Box 1060, Jones, MS.
(mailing address)

WELL LOCATION:
sec. 17 T 5 N R 4 E
0 miles SW of Jettlet
(distance) (direction) (nearest town)

WELL PURPOSE: Home
(home, irrigation, municipal, industrial)

WELL COMPLETION DATA:

(1) diameter (inches) 5"

(2) total depth (feet) 420'

(3) static water level (feet) 176' below above top of ground.

(4) casing steel 23' 10"
(material) (depth)

5 if telescope see back.
(size)

(5) screen no
(length) (depth to top)

 (size) (material)

(6) pump 3/4 10
(HP) (yield gpm)


electric
(type power)

(7) electric log no
(yes or no)

(organization running log)

(8) how well bottom plugged open


description of formations encountered	from	to
<u>surface sand</u>		
<u>& clay</u>	<u>0'</u>	<u>18'</u>
<u>blue clay</u>	<u>18'</u>	<u>280'</u>
<u>sand</u>	<u>280'</u>	<u>420'</u>
<u>bottom</u>	<u>420'</u>	

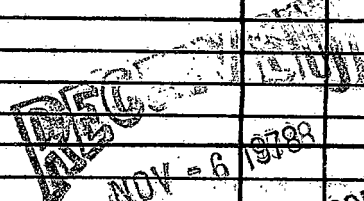
 NOV - 6 1978
 MISS. Bd. OF WATER COMMISSIONERS

DRILLERS REMARKS:

If well telescopes please sketch and show depths.

GROUND LEVEL

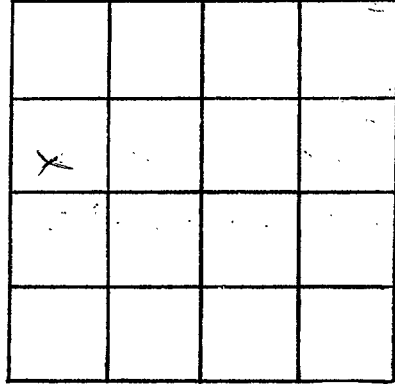

SECTION 17

Please indicate well location X.

ADDITIONAL INFORMATION

A series of horizontal lines for entering additional information.

If more than one screen, show locations of each on sketch.