

Monroe
A 2021
10-28-79

MISSISSIPPI
BOARD OF WATER COMMISSIONERS
416 North State Street
Jackson, Mississippi 39201

WATER WELL DRILLERS LOG

10-28-79 date well completed
Hernan Homan Well & Supply, Inc. firm name
SHANNON MISSISSIPPI 39268
Monroe county well located

LANDOWNER:
Fredrick Jones
Rt 1 Old Snow Hill
(mailing address)

description of formations encountered	from	to
surface clay	0	18
Blue clay	18	300
sand	300	400
Bottom	440	

WELL LOCATION:
sec. 17 T. 12 N. R. 6 E
3 miles SW of Nettie
(distance) (direction) (nearest town)

WELL PURPOSE: Farm
(home, irrigation, municipal, industrial)

- WELL COMPLETION DATA:
- (1) diameter (inches) 5 1/4
 - (2) total depth (feet) 440'
 - (3) static water level (feet) 131' below top of ground.
 - (4) casing Steel 23' (material) (depth)
5 1/4 (size) if telescope see back.
 - (5) screen 20' (length) (depth to top)
(size) (material)
 - (6) pump 3/4 HP 8 (yield gpm)
electric (type power)
 - (7) electric log NO (yes or no)
(organization running log)
 - (8) how well bottom plugged open

DRILLERS REMARKS:


DEPT. OF NATURAL RESOURCES
BUREAU OF LAND & WATER

DEC - 7 1979

RECEIVED

If well telescopes please sketch and show depths.

GROUND LEVEL

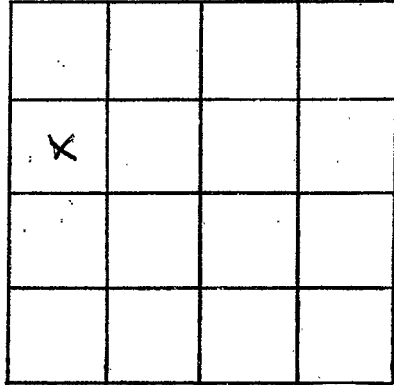

SECTION 17

Please indicate well location X.

ADDITIONAL INFORMATION

If more than one screen,
show locations of each on sketch.