

Monroe
 A 2000
 10-29-79

MISSISSIPPI
 BOARD OF WATER COMMISSIONERS
 416 North State Street
 Jackson, Mississippi 39201

WATER WELL DRILLERS LOG

10-29-79 19 75 date well completed
 Herman Homan Well & Supply, Inc.
 P. O. Box 42
 firm name SHANNON, MISSISSIPPI 38268
 Monroe county well located

LANDOWNER:
 Thomas Seymour
 Rt 2 Nettleton Ms
 (mailing address)

description of formations encountered	from	to
5 in of fine sand	0	16
blue clay	16	160
sand	160	300
Bottom	300	

WELL LOCATION:
 sec. 3 T. 12 N. R. 6 E
 2 miles S W of Nettleton
 (distance) (direction) (nearest town)

WELL PURPOSE:
 Home
 (home, irrigation, municipal, industrial)

- WELL COMPLETION DATA:
- (1) diameter (inches) 5"
 - (2) total depth (feet) 300'
 - (3) static water level (feet) 105' below above top of ground.
 - (4) casing steel, 20' 6" (material) (depth)
 5" if telescope see back. (size)
 - (5) screen NO (length) (depth to top)
 (size) (material)
 - (6) pump 1/2 (HP) 5 (yield gpm)
 electric (type power)
 - (7) electric log NO (yes or no)
 (organization running log)
 - (8) how well bottom plugged open

DRILLERS REMARKS:


DEPT. OF NATURAL RESOURCES
 BUREAU OF LAND & WATER CONSERVATION

DEC - 7 1979

RECEIVED

If well telescopes please sketch and show depths.

GROUND LEVEL

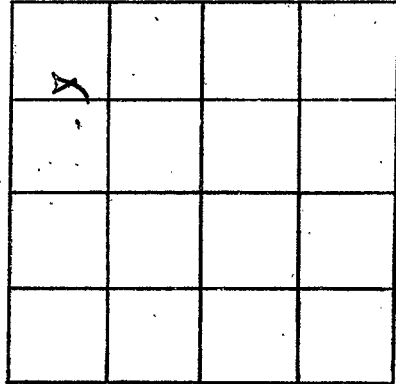

SECTION 3

Please indicate well location X.

ADDITIONAL INFORMATION

Lined area for additional information.

If more than one screen, show locations of each on sketch.