

MISSISSIPPI DEPARTMENT OF ENVIRONMENTAL QUALITY
Bureau of Land and Water Resources

P. O. Box 10631
Jackson, MS 39289-0631
WATER WELL DRILLERS LOG

COUNTY WELL LOCATED <u>Monroe</u>	
WELL NUMBER <u>A</u> <u>2031</u>	CODED
DATE WELL COMPLETED <u>02/10/93</u>	

PERMIT NUMBER
NAME OF DRILLING FIRM <u>Herrdow Well & Supply</u>
<u>Shannon, MS</u>

NAME & MAILING ADDRESS OF LANDOWNER <u>Willie Lockett</u>		
<u>Rt 2, Box 387</u>		
<u>Nettleton, MS 38858</u>		
WELL LOCATION: SEC	TOWNSHIP	RANGE
<u>23</u>	<u>12</u>	<u>6</u> <u>E</u>
DISTANCE	DIRECTION	NEAREST TOWN
<u>3 1/4</u> Miles	<u>S</u> of	<u>Nettleton</u>
OTHER LANDMARK		
WELL PURPOSE: Home, Irrigation, Municipal, Industrial, Fish Pond, etc. <u>Home</u>		

PUMP DATA		
PUMP TYPE (Circle One): <u>Submersible</u> , Turbine, Jet, Flowing Well, Other (Describe) _____		
POWER TYPE (Circle One): <u>Electric</u> , Tractor, Diesel, Gasoline, Butane, Other (Describe) _____ H/P <u>1/2</u>		
Pump Capacity (GPM) <u>5</u>	No. of Stages <u>13</u>	Setting Depth <u>189</u> FT.
PUMP TEST		
Well yielded _____ GPM with a drawdown of _____ ft. after _____ hours of pumping		

WELL DATA		
Well Depth <u>390'</u>	Casing Diameter (In.) <u>5"</u>	Casing Length (Ft.) <u>35'</u>
Type of Casing <u>Steel</u>	Hole Depth <u>390'</u>	Depth to Static Water Level <u>140'</u>
TYPE OF COMPLETION: (Circle One or More): <u>Gravel Packed</u> , Underreamed, Telescoped, Natural Development, Open Hole, Other (Describe) _____		
Top of Lap Pipe or Reduction in Casing		
FEET		
IF TELESCOPED OR MORE THAN ONE SCREEN: USE BACK PAGE		

LOG DATA	
TYPE OF LOG RUN (Circle One): Electric, Gamma Ray, Density, Sonic, Neutron, Other (Describe) _____ <u>No Log Run</u>	
Name of Organization Running Log	

SCREEN DATA		
Diameter - Inches <u>N/A</u>	Length - Feet	Slot Size - Inches
Screen Type	Depth to Bottom - Feet	


GEOLOGIC DATA (Office Use Only)			
Surface Elev.	Geologic Unit	Unit Thickness	Depth to Top
Subs. SWL	Date	Analysis	Aquifer Test
Driller's Remarks			

DESCRIPTION OF FORMATIONS ENCOUNTERED	FROM	TO	FORMATIONS (Continued)	FROM	TO
<u>Brown Clay</u>	<u>0</u>	<u>18</u>	RECEIVED FEB 12 1993 Dept. of Environmental Quality Office of Land & Water Resources		
<u>Blue Clay</u>	<u>18</u>	<u>150</u>			
<u>(Rock @ 150' - 1'12")</u>					
<u>Sand</u>	<u>150</u>	<u>385</u>			
<u>Blue Clay</u>	<u>385</u>	<u>390</u>			

IF MORE SPACE IS NEEDED, USE BACK

If well telescopes please
sketch and show depths.

GROUND LEVEL

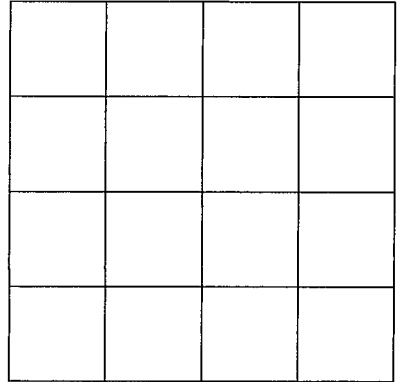

SECTION _____

Please indicate well location X.

ADDITIONAL INFORMATION

If more than one screen,
show location of each on sketch.