

MONROE
B18
7-1-71
7-1

MISSISSIPPI
BOARD OF WATER COMMISSIONERS
416 North State Street
Jackson, Mississippi 39201

CODED

WATER WELL DRILLERS LOG

Herndon-Homan Well & Supply, *MA* *2*

date well completed 19 *71* P. O. Box *42* *2*
 name of well *SEANOR* county well located *MA*

LANDOWNER: *Aubrey Plunkett*
Box 50 HW 6E 9632074
Nuttleton, Miss.
 (mailing address)

description of formations encountered	from	to
<i>Surface sand & clay</i>	<i>0</i>	<i>59</i>
<i>Blue clay</i>	<i>59</i>	<i>85</i>
<i>Sand</i>	<i>85</i>	<i>190</i>
<i>Bottom</i>	<i>190</i>	

WELL LOCATION:
 sec. *5* T *12* R *7* E
1 miles *SE* of *Nuttleton*
 (distance) (direction) (nearest town)

WELL PURPOSE: *Home*
 (home, irrigation, municipal, industrial)

- WELL COMPLETION DATA:
- diameter (inches) *5"*
 - total depth (feet) *190'*
 - static water level (feet) *16* below above top of ground.
 - casing *Steel* *13'*
 (material) (depth)
5" if telescope see back.
 (size)
 - screen *no*
 (length) (depth to top)
 (size) (material)
 - pump *1/2* *10*
 (HP) (yield gpm)
electric
 (type power)
 - electric log *no*
 (yes or no)
 - (organization running log)
 - how well bottom plugged *open*

CODED


JUL 7 2 1971

MISS. BD. OF
 WATER COMMISSIONERS

DRILLERS REMARKS:

If well telescopes please sketch and show depths.

GROUND LEVEL

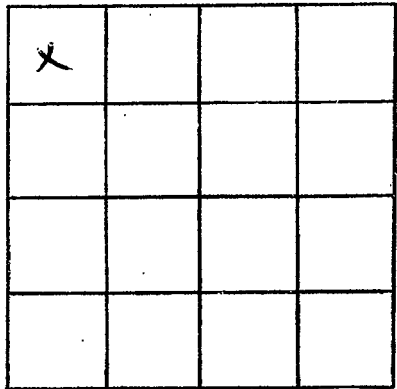

SECTION 5

Please indicate well location X.

ADDITIONAL INFORMATION

If more than one screen,
show locations of each on sketch.