

CODED

CODED

CODED

Monroe
B 19
12-12-68

MISSISSIPPI
BOARD OF WATER COMMISSIONERS
416 North State Street
Jackson, Mississippi 39201

WATER WELL DRILLERS LOG

12-12 1968 W. J. REEVES & SON MONROE
date well completed Page 1 Br firm name county well located

LANDOWNER: KENNETH REIGH
256 3530

803 11 AVE. No.

AMORY, MISS
(mailing address)

WELL LOCATION:

sec. 34 T 12 N R 7 E
S 31
3 miles W of AMORY
(distance) (direction) (nearest town)

WELL PURPOSE: CATTLE
(home, irrigation, municipal, industrial)

WELL COMPLETION DATA:

- (1) diameter (inches) 2
- (2) total depth (feet) 263
- (3) static water level (feet) 8 ~~below~~ above top of ground.
- (4) casing STEEL, 231
(material) (depth)
(size) If telescope see back.
- (5) screen 21 210
(length) (depth to top)
2 STEEL
(size) (material)
- (6) pump NONE
(HP) (yield gpm)
(type power)
- (7) electric log NO
(yes or no)
(organization running log)
- (8) how well bottom plugged OPEN

description of formations encountered

from to

CLAY	0	12
RED SAND	12	40
BLUE SAND	40	90
" CLAY	90	98
" SAND	98	115
" CLAY	115	220
WHITE SAND	220	243
BLUE CLAY-SAND STRKS	243	263

CODED

DRILLERS REMARKS:


15 CPM FLOW - THREE FEET ABOVE GROUND

DATE OF DRILLING
MATERIAL USED

JAN 10 1969

If well telescopes please sketch and show depths.

GROUND LEVEL

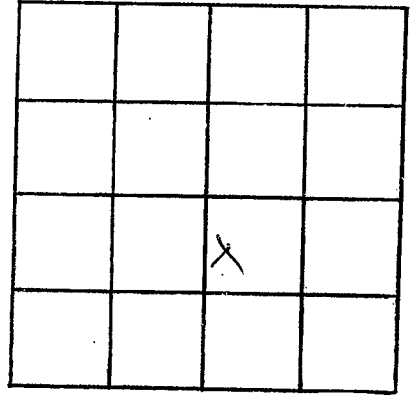

SECTION 34

Please indicate well location X.

ADDITIONAL INFORMATION

If more than one screen,
show locations of each on sketch.