

CODED

MONROE
B 20
2-26-69

MISSISSIPPI
BOARD OF WATER COMMISSIONERS
416 North State Street
Jackson, Mississippi 39201

WATER WELL DRILLERS LOG

2-28-1969 Herndon-Homan Well & Supply, Inc. *W. H. H. H.*
date well completed *2 H. H. H. Post R.E.* firm name Box 42 county well located
SHANTON MISSISSIPPI 38868

LANDOWNER: *METTS RD 963 3202*

description of formations encountered	from	to
<i>See Hall</i>	<i>0</i>	<i>38</i>
<i>Nettleton, Miss.</i>	<i>38</i>	<i>60</i>
<i>Ground</i>	<i>60</i>	<i>180</i>
<i>Bottom</i>	<i>180</i>	

See Hall
Nettleton, Miss.
(mailing address)

WELL LOCATION:
32 sec. *11* T. *11* N. R. *7* E. S. *W*
1.4 miles *SE* of *Nettleton*
(distance) (direction) (nearest town)

WELL PURPOSE: *Home*
(home, irrigation, municipal, industrial)

WELL COMPLETION DATA:

- (1) diameter (inches) *8 1/2*
- (2) total depth (feet) *180*
- (3) static water level (feet) *40* below above top of ground.
- (4) casing *Steel* *2 1/2"*
(material) (depth)
- 4* If telescope see back.
(size)
- (5) screen *ND*
(length) (depth to top)
- (size) (material)
- (6) pump *1/2* *5*
(HP) (yield gpm)
- electric*
(type power)
- (7) electric log *ND*
(yes or no)

(organization running log)

(8) how well bottom plugged *open*

DRILLERS REMARKS:


CODED

APP - 5 1969

MISS. BD OF
WATER COMMISSIONERS

If well telescopes please sketch and show depths.

GROUND LEVEL

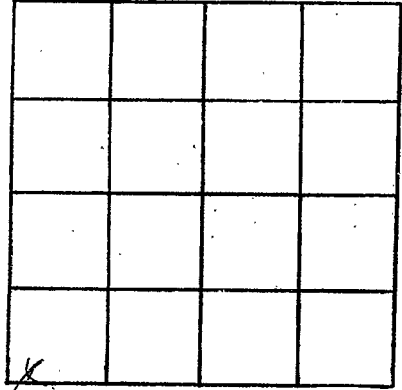

SECTION 32

Please indicate well location X.

ADDITIONAL INFORMATION

A series of horizontal lines for recording additional information.

If more than one screen, show locations of each on sketch.