

CODED

MISSISSIPPI
BOARD OF WATER COMMISSIONERS
416 North State Street
Jackson, Mississippi 39201

MONROE
B 21
3-5-69

WATER WELL DRILLERS LOG

3/5 1965 Herndon-Homan Well & Supply, Inc. MONROE
date well completed 1965 firm name BOX 24 county well located
KEARNEY JONES SHANNON, MISSISSIPPI 38868

LANDOWNER: contractor
Olin Jones
Rt 2 Across Miss
(mailing address)

description of formations encountered	from	to
Surface mud & clay	0	18
Blue clay	18	60
Sand	60	180
Gravel	180	

WELL LOCATION:
32 sec. 31 T. 11 N. R. 7 E. S. 1 W.
1 miles E of Nettleton
(distance) (direction) (nearest town)

WELL PURPOSE: Home
(home, irrigation, municipal, industrial)

- WELL COMPLETION DATA:
- (1) diameter (inches) 4
 - (2) total depth (feet) 180
 - (3) static water level (feet) 50 below above top of ground.
 - (4) casing steel, 21' (material), (depth)
4 (size) if telescope see back.
 - (5) screen 20 (length), (depth to top)
(size) (material)
 - (6) pump 3/4 (HP), 5 (yield gpm)
electric (type power)
 - (7) electric log no (yes or no)
(organization running log)
 - (8) how well bottom plugged open

DRILLERS REMARKS:


CODED

MISS. Bd. of
WATER COMMISSIONERS

1969

If well telescopes please sketch and show depths.

GROUND LEVEL

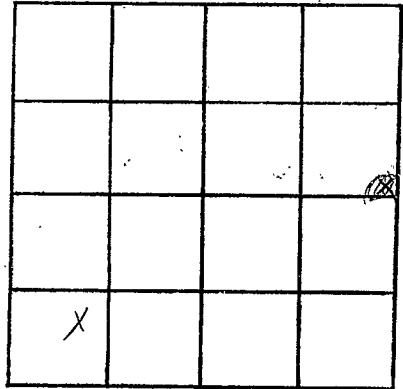

SECTION ~~30~~ 32

Please indicate well location X.

ADDITIONAL INFORMATION

Lined area for additional information.

If more than one screen, show locations of each on sketch.