

Monroe
B 212
4 - 69

MISSISSIPPI
BOARD OF WATER COMMISSIONERS
416 North State Street
Jackson, Mississippi 39201

WATER WELL DRILLERS LOG

date well completed 4 - 19 69 Herndon-Homan Well & Supply, Inc. Monroe
firm name
SHANNON, MISSISSIPPI 38868 county well located

LANDOWNER: contacted

Olew Jones
Rt 2 Amory, Miss
(mailing address)

description of formations encountered

from to

Surface sand & clay 0 18
Blue clay 18 70
Sand 70 180
Ditto 180

WELL LOCATION:

sec 31 T 11 N R 2 E
S
1/4 miles E of Nettie
(distance) (direction) (nearest town)

WELL PURPOSE:

(home, irrigation, municipal, industrial) Home

WELL COMPLETION DATA:

- (1) diameter (inches) 4
- (2) total depth (feet) 180
- (3) static water level (feet) 50 below top of ground.
- (4) casing steel, 21' (material) (depth)
4 (size) if telescope see back.
- (5) screen 110 (length) (depth to top)
(size) (material)
- (6) pump 3/4 (HP) 3 (yield gpm)
electric (type power)
- (7) electric log 110 (yes or no)

(organization running log)

- (8) how well bottom plugged open

DRILLERS REMARKS:


MAY 26 1969

MISS. Bd. of
WATER COM.

H.W. 371
256 5576

If well telescopes please sketch and show depths.

GROUND LEVEL

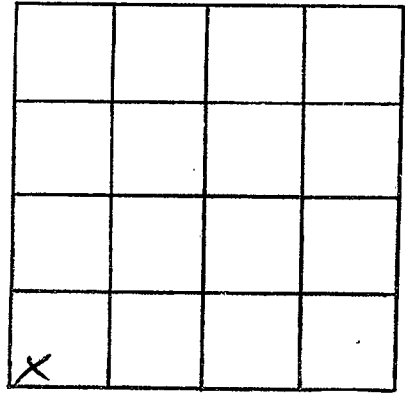

SECTION 31

Please indicate well location X.

ADDITIONAL INFORMATION

If more than one screen, show locations of each on sketch.