

Monroe
B 25
2-18-70

MISSISSIPPI
BOARD OF WATER COMMISSIONERS
416 North State Street
Jackson, Mississippi 39201

WATER WELL DRILLERS LOG

Hendon-Homan Well & Supply, Inc.

P. O. Box 41

Monroe

2-18 19 70

date well completed

STANTON, MISSISSIPPI, 39809

county well located

LANDOWNER:

John McBurne

Netleton, Miss. P.O. Box
(mailing address)

description of formations
encountered

from

to

Finest sand & clay	0	30
Red clay	30	40
Sand	40	122
Bottom	122	

WELL LOCATION:

sec. 3 T. 14 R. 7 E
3 1/2 miles SE of Netleton
(distance) (direction) (nearest town)

WELL PURPOSE: Home
(home, irrigation, municipal, industrial)

WELL COMPLETION DATA:

- diameter (inches) 4"
- total depth (feet) 120
- static water level (feet) 38 below top of ground.
- casing (material) steel, (depth) 33'
4" if telescope see back.
(size)
- screen (length) no (depth to top)
- pump (HP) 3/4 (material) 5 (yield gpm)
Electric (type power)
- electric log no (yes or no)
- (organization running log)
- how well bottom plugged open


DRILLERS REMARKS:

MAR 9 - 1970

MISS. BD. OF
WATER COMMISSIONERS

If well telescopes please sketch and show depths.

GROUND LEVEL

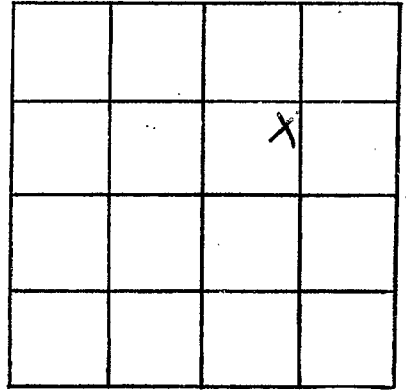

SECTION 5

Please indicate well location X.

ADDITIONAL INFORMATION

If more than one screen,
show locations of each on sketch.