

MISSISSIPPI
 BOARD OF WATER COMMISSIONERS
 416 North State Street
 Jackson, Mississippi 39201

WATER WELL DRILLERS LOG

Herdon-Homan Well & Supply, Inc.

CODED

Monroe
 B 27
 5-8-70

5-8 19 70 P. O. Box 42 MONROE
 date well completed SHANNON, MISSISSIPPI 38868 county well located

LANDOWNER: Clinton Mills
Nettleton, Miss.
Old motto Rd. 963 2929
 (mailing address)

description of formations encountered	from	to
<u>Surface sand & clay</u>	<u>0</u>	<u>28</u>
<u>clay</u>	<u>28</u>	<u>40</u>
<u>Sand</u>	<u>100</u>	<u>140</u>
<u>Both</u>	<u>140</u>	

WELL LOCATION:
 sec. 6 T. 12 S. R. 7 E.
1/2 miles SF of Nettleton
 (distance) (direction) (nearest town)

WELL PURPOSE: home
 (home, irrigation, municipal, industrial)

- WELL COMPLETION DATA:
- (1) diameter (inches) 5"
 - (2) total depth (feet) 140'
 - (3) static water level (feet) 40 below top of ground.
 - (4) casing Steel, 32'
 (material) (depth)
5" if telescope see back.
 (size)
 - (5) screen ND
 (length) (depth to top)
 (size) (material)
 - (6) pump NO
 (HP) (yield gpm)
 (type power)
 - (7) electric log NO
 (yes or no)
 (organization running log)
 - (8) how well bottom plugged open


CODED

JUN 25 1970

DRILLERS REMARKS:

If well telescopes please sketch and show depths.

GROUND LEVEL

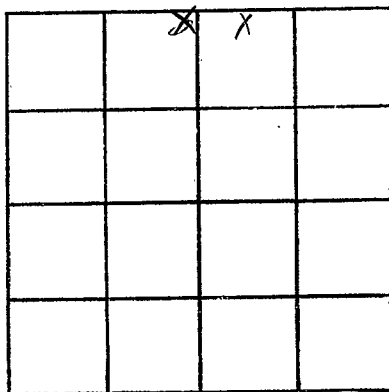

SECTION 6

Please indicate well location X.

ADDITIONAL INFORMATION

If more than one screen, show locations of each on sketch.