

Monroe  
B 28  
5-26-70

MISSISSIPPI  
BOARD OF WATER COMMISSIONERS  
416 North State Street  
Jackson, Mississippi 39201

**CODED**

WATER WELL DRILLERS LOG

5-26 1970 Herndon-Horsan Monroe  
date well completed firm name county well located

LANDOWNER Lucie Blake  
Nettleton, Miss  
(mailing address)

description of formations encountered	from	to
<u>Surface sand &amp; clay</u>	<u>0</u>	<u>23</u>
<u>Blue clay</u>	<u>23</u>	<u>30</u>
<u>Sand</u>	<u>30</u>	<u>130</u>
<u>Blk</u>	<u>130</u>	

WELL LOCATION:  
sec. 34 T. 11 N. R. 7 E  
4 miles E of Nettleton  
(distance) (direction) (nearest town)

WELL PURPOSE: Home  
(home, irrigation, municipal, industrial)

- WELL COMPLETION DATA:
- (1) diameter (inches) 5"
  - (2) total depth (feet) 130'
  - (3) static water level (feet) 63 below above top of ground.
  - (4) casing Steel 25'  
(material) (depth)  
5" if telescope see back.  
(size)
  - (5) screen 70   
(length) (depth to top)  
(size) (material)
  - (6) pump 1/3 5  
(HP) (yield gpm)  
Electric  
(type power)
  - (7) electric log NO  
(yes or no)  
(organization running log)
  - (8) how well bottom plugged Open

**CODED**


JUN 15 1970

DRILLERS REMARKS:

MISSISSIPPI  
BOARD OF WATER COMMISSIONERS

If well telescopes please sketch and show depths.

GROUND LEVEL

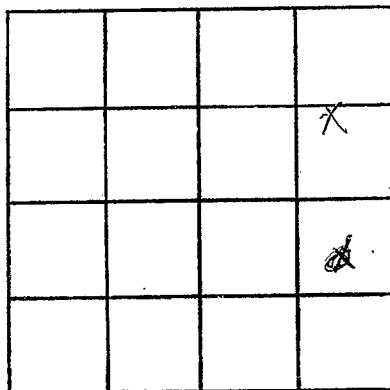

SECTION *BY*

Please indicate well location X.

ADDITIONAL INFORMATION

If more than one screen, show locations of each on sketch.