

MISSISSIPPI  
BOARD OF WATER COMMISSIONERS  
416 North State Street  
Jackson, Mississippi 39201

**CODED**

WATER WELL DRILLERS LOG

MONROE  
B29  
12-15-70

12-15 1970 Herndon-Homan Well Monroe  
date well completed firm name county well located

Supply

LANDOWNER: Wendell Wheeler  
Nittleton, Miss. 38858  
9632136  
(mailing address)

description of formations encountered	from	to
<u>Surface sand</u>	<u>0</u>	<u>50</u>
<u>Blue clay</u>	<u>50</u>	<u>80</u>
<u>Sand</u>	<u>80</u>	<u>200</u>
<u>Bottom</u>	<u>200</u>	

WELL LOCATION:  
sec. 5 T 12 N R 7 E  
S W  
1 miles SE of Nittleton  
(distance) (direction) (nearest town)

WELL PURPOSE: Home  
(home, irrigation, municipal, industrial)

- WELL COMPLETION DATA:
- (1) diameter (inches) 5"
  - (2) total depth (feet) 200'
  - (3) static water level (feet) 41 below above top of ground.
  - (4) casing Steel 54'  
(material) (depth)  
5" if telescope see back.  
(size)
  - (5) screen 40  
(length) (depth to top)  
(size) (material)
  - (6) pump 1/3 5  
(HP) (yield gpm)  
Electric  
(type power)
  - (7) electric log no  
(yes or no)
  - (organization running log)
  - (8) how well bottom plugged open

**CODED**


JAN 17 1971

MISSISSIPPI BOARD OF WATER COMMISSIONERS  
WATER CONTROL DIVISION

DRILLERS REMARKS:

If well telescopes please sketch and show depths.

GROUND LEVEL

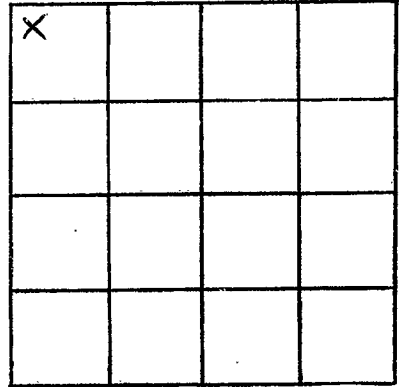

SECTION 5

Please indicate well location X.

ADDITIONAL INFORMATION

If more than one screen,  
show locations of each on sketch.