

Monroe  
B 32  
4-67

MISSISSIPPI  
BOARD OF WATER COMMISSIONERS  
416 North State Street  
Jackson, Mississippi 39201

**CODED**

WATER WELL DRILLERS LOG  
Herndon-Homan Well & Supply, Inc.

4-11 19 67 P. O. Box 42 Madison  
date well completed SEANNON MISSISSIPPI 38368 county well located  
*some feet above*

LANDOWNER: 963 2334  
Frank Sisk  
Nettleton Miss.  
(mailing address)

description of formations encountered	from	to
Surface sand clay	0	30
Blue clay	30	80
Sand	80	200
Bottom	200	


WELL LOCATION:  
sec. 6 T. 12 N R. 7 E  
S W  
1/2 miles SE of Nettleton  
(distance) (direction) (nearest town)

WELL PURPOSE: Levee  
(home, irrigation, municipal, industrial)

WELL COMPLETION DATA:

- (1) diameter (inches) 5
- (2) total depth (feet) 200
- (3) static water level (feet) 65 below above top of ground.
- (4) casing steel, 36'  
(material) (depth)  
5 if telescope see back.  
(size)
- (5) screen None  
(length) (depth to top)  
(size) (material)
- (6) pump B others  
(HP) (yield gpm)  
(type power)
- (7) electric log no  
(yes or no)  
(organization running log)
- (8) how well bottom plugged open

**CODED**

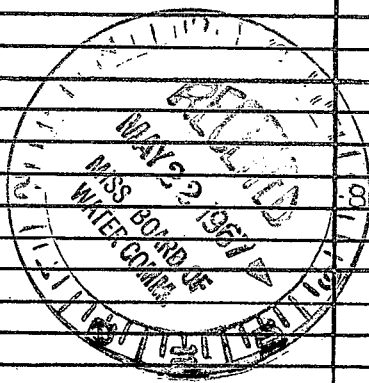

DRILLERS REMARKS:

If well telescopes please sketch and show depths.

GROUND LEVEL

X			

SECTION 6

Please indicate well location X.

ADDITIONAL INFORMATION

If more than one screen, show locations of each on sketch.