

MONROE

WATER

B33

Date: 3/19, 1962, Driller: James J. Lee County Monroe
3-19-62 (Name)

(1) Owner of Land: Glenn Ricks

(Name)

Mettleton 9632104

(Address)

32

(2) Location: NE SW SW 32
1/4, 1/4, Sec B1 T15R7E

2 miles E of mettleton
(distance) (direction) (Nearest Town)

(3) Topography: Hilly

(Hilly)

(Flat)

(Level)

(4) Purpose of Well: DOMESTIC

(Domestic Irrigation
Municipal, Industrial, Other)

Description & Color of Materials
Sand, Clay, Red Clay, Silts

CODED

Thick-
ness
Feet

Depth-
Feet

CODED

Information upon completion of well:

(1) Diameter 4" inches.

(2) Total Depth 224' feet.

(3) Water Level 40' feet below top of ground.

(4) Cased to 26', Size 4"

(5) Screen: Size _____, Length _____


(6) Were any formations sealed against pollution?

yes, no.

If YES depth of formation _____

Why _____

Drillers Remarks: _____

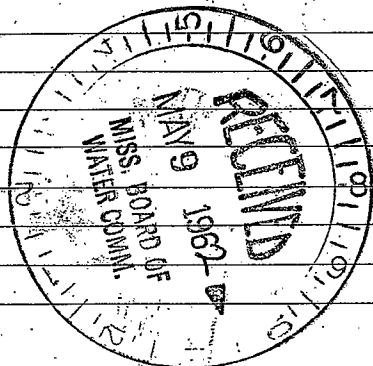

(Use Back Side)

Well No.

1944

...

...

