

Monroe

B35

9-65

MISSISSIPPI BOARD OF WATER COMMISSIONERS

WATER WELL DRILLERS LOG

CODED

Date: Sept. 4, 1965 Driller: Herrndon-Homan Well & Supply, Inc. County: Monroe
(When well drilled) 2 Br no NL SHANNON, MISSISSIPPI 39880 (Where well is located)

(1) Owner of Land: Alford Sumner
(Name)
H 26 E
9632492 Nettleton, Miss.
(Address)
NW
(2) Location: 1/4 NW 1/4, Sec 32 T11R7, E
1/2 miles EAST of Nettleton
(distance) (direction) (Nearest Town)
(3) Topography: Flat
(Hilly) (Flat) (Level)
(4) Purpose of Well: Domestic
(Domestic Irrigation
Municipal, Industrial, Other)


Description & Color of Materials Sand, Clay, Red Clay, Shell, etc.	Thick- ness Feet	Depth Feet
<u>surface sand & clay</u>		<u>18</u>
<u>Blue clay</u>	<u>107</u>	<u>125</u>
<u>Sand</u>	<u>115</u>	<u>240</u>

Information upon completion of well:

(1) Diameter 5 inches.
(2) Total Depth 240 feet.
(3) Water Level 57 feet below top of ground.
(4) Cased to 20' 4", Size 5"
(5) Screen: Size NONE, Length _____
(6) Were any formations sealed against pollution?
✓ yes, _____ no.

CODED

If YES depth of formation 146'
Why Surface & sand
Drillers Remarks: _____
Yield in gpm: 5
Size pump: 1/3
Type power: Electric

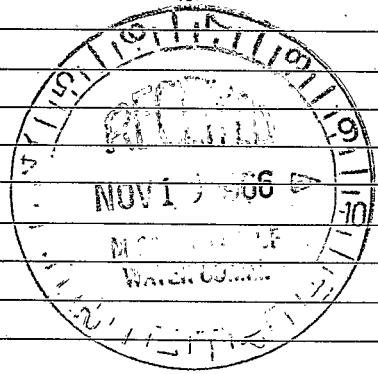

[The page contains extremely faint and illegible text, likely bleed-through from the reverse side of the document. The text is scattered across the page and cannot be transcribed accurately.]