

MONROE

B38

11-9-62

MISSISSIPPI BOARD OF WATER COMMISSIONERS

WATER WELL DRILLERS LOG

CODED

HERNDON WELL & SUPPLY CO.

Date: Nov 9, 1962, Driller: P. O. BOX 42 County Monroe

SHANNON, MISSISSIPPI

TAKE LEFT AT BRICK STORE 1st house on Rth corner Hill

(1) Owner of Land:	Description & Color of Materials Sand, Clay, Red Clay, Shell, etc.	Thickness Feet	Depth Feet
G. W. Airdings (Name)	surface sand		0
At 2 Amory, Miss PINE GROVE (Address)	d clay		38
(2) Location: NE 1/4, SE 1/4, Sec. 3 T. 15 R. 7 E	Blue rock		42
4 miles SE, of Nettie (distance) (direction) (Nearest Town)	sand		80
(3) Topography: Flat (Hilly) (Flat) (Level)	Bottom		
(4) Purpose of Well: Domestic (Domestic Irrigation Municipal, Industrial, Other)			

Information upon completion of well:


- (1) Diameter 4 inches.
- (2) Total Depth 80 feet.
- (3) Water Level 70 feet below top of ground.
- (4) Cased to 41', Size 4"
- (5) Screen: Size _____, Length _____.
- (6) Were any formations sealed against pollution?
yes, no.

If YES depth of formation 38'

Why surface & sand

Drillers Remarks:

CODED

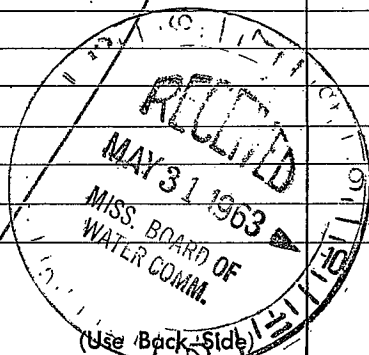

Well No.

