

**CODED**

MISSISSIPPI  
BOARD OF WATER COMMISSIONERS  
416 North State Street  
Jackson, Mississippi 39201

FEB 14 1972

**WATER WELL DRILLERS LOG**

MISS. DE

Herndon-Homan Well & Supply, Inc.

P. O. Box 42

Monroe

SHANNON, MISSISSIPPI 38868 county well located

**MONROE**  
**B 39**  
**1-25-72**

1-25-1972  
date well completed

LANDOWNER:  
Jimmy Sullivan  
Nottleton Miss.  
(mailing/address)

description of formations encountered	from	to
Surface sand & clay	0	42
Blue clay	42	60
Sand	60	180
Bottom	180	

WELL LOCATION:  
sec. 6 T. 12 S. R. 7 E.  
1 1/2 miles SE of Nottleton  
(distance) (direction) (nearest town)

WELL PURPOSE: Home  
(home, irrigation, municipal, industrial)


- WELL COMPLETION DATA:
- (1) diameter (inches) 5"
  - (2) total depth (feet) 180'
  - (3) static water level (feet) 29' below top of ground.
  - (4) casing (material) steel, (depth) 45'
  - (size) 5" if telescope see back.
  - (5) screen (length) NO, (depth to top) NO
  - (size) (material)
  - (6) pump (HP) 1/2, (yield gpm) 5"
  - (type power) electric
  - (7) electric log NO (yes or no)
  - (organization running log)
  - (8) how well bottom plugged open

**CODED**

DRILLERS REMARKS:

If well telescopes please sketch and show depths.

GROUND LEVEL

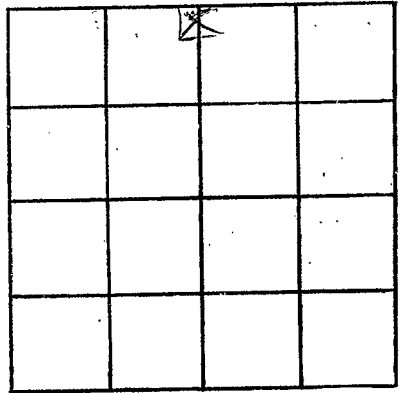

SECTION 6

Please indicate well location X.

ADDITIONAL INFORMATION

If more than one screen, show locations of each on sketch.