

MONROE

MISSISSIPPI BOARD OF WATER COMMISSIONERS

B42

WATER WELL DRILLERS LOG

CODED

B302

B302

8-11-61

Driller: HERNDON WELL & SUPPLY CO. County: Monroe

P.O. BOX 42

SHANNON, MISSISSIPPI

Central GROVE RD. 2568694

(1) Owner of Land: Mrs J G Caldwell

(Name)

At Aberdeen, Miss

(Address)

(2) Location: NW SW SW 1/4, Sec 29, T 25 R 17

6 miles West of Amory

(distance)

(direction)

(Nearest Town)

(3) Topography: Flat

(Hilly)

(Flat)

(Level)

(4) Purpose of Well: Domestic

(Domestic Irrigation  
Municipal, Industrial, Other)

Description & Color of Materials  
Sand, Clay, Red Clay, Shell, etc.

Thick-  
ness  
Feet

Depth  
Feet

Surface SAND  
& clay

0

Blueish

20

Sand

100

Bottom

220

Information upon completion of well:

(1) Diameter 4 inches.

(2) Total Depth 220 feet.

(3) Water level 120 feet below top of ground.

(4) Cased to 25', Size 4"

(5) Screen: Size \_\_\_\_\_, Length \_\_\_\_\_

(6) Were any formations sealed against pollution?


yes, no.

If YES depth of formation \_\_\_\_\_

Why Surface & sand

Drillers Remarks:

CODED

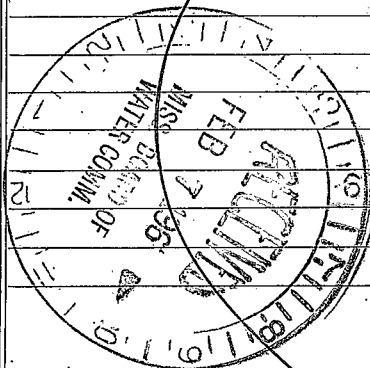

(Use Back Side)

Well No.

...the ... of ...

...the ... of ...

