

MONROE

B43

5-67

MISSISSIPPI BOARD OF WATER COMMISSIONERS

CODED

WATER WELL DRILLERS LOG

Horndon-Homan Well & Supply, Inc.

Date: 5-2, 1967, Driller: P O Box 42, County Monroe, SLANTON, MISSISSIPPI 38868

(1) Owner of Land: Milked Mills (Name)
Nettleow, Miss (Address)
(2) Location: SW SE NW 32 1/4, 1/4, Sec. 11, R. 5, S. 7
(3) Topography: Flat (Level)
(4) Purpose of Well: Home (Domestic Irrigation)


Table with 3 columns: Description & Color of Materials, Thickness Feet, Depth Feet. Contains handwritten entries for sand, clay, and silt layers.

Information upon completion of well:

(1) Diameter: 4 inches.
(2) Total Depth: 200 feet.
(3) Water Level: 85 feet below top of ground.
(4) Cased to: 23', Size: 4"
(5) Screen: Size: none, Length:
(6) Were any formations sealed against pollution? yes

If YES depth of formation: 20'
Why: surface sand
Drillers Remarks:
Yield in gpm: 5
Size pump: 3/4 1/2 hp
Type power: electric

CODED

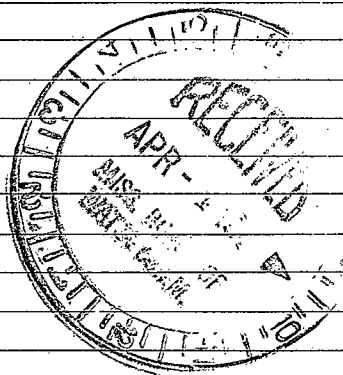

Retain this copy for your office files.

