

MONROE

B 45

WATER WELL DRILLERS LOG

CODED

3-25-63

HERNDON WELL & SUPPLY CO.

Date: March 25, 1963, Driller:

P.O. BOX 42 County: Monroe

SHANNON, MISSISSIPPI

(1) Owner of Land: Felix Cozzino
 (Name)
Okolona, Miss.
 (Address)

(2) Location: NW 1/4, SW 1/4, Sec. 32 T. 15 N. R. 7 E
2 miles SE, of Nettleton
 (distance) (direction) (Nearest Town)

(3) Topography: Flat
 (Hilly) (Flat) (Level)

(4) Purpose of Well: Domestic
 (Domestic Irrigation, Municipal, Industrial, Other)

Description & Color of Materials Sand, Clay, Red Clay, Shell, etc.	Thick- ness Feet	Depth Feet
<u>surface sand</u>		<u>0</u>
<u>& clay</u>		
<u>to</u>		
<u>blue sand</u>		<u>15</u>
<u>to</u>		
<u>hard</u>		<u>40</u>
<u>to</u>		
<u>bottom</u>		<u>140</u>

Information upon completion of well:

(1) Diameter 4 inches.

(2) Total Depth 140 feet.

(3) Water Level 20 feet below top of ground.

(4) Cased to 19'4", Size 4"

(5) Screen: Size _____, Length _____


(6) Were any formations sealed against pollution?
 yes, _____ no.

If YES depth of formation 15 ft.

Why surface & found

Drillers Remarks:

CODED

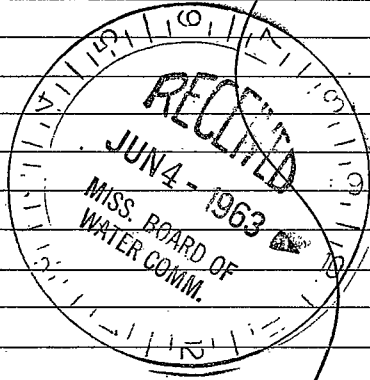

Well No.

(Use Back Side)

