

MONROE
B-46
2-10-61

MISSISSIPPI BOARD OF WATER COMMISSIONERS

CODED

WATER WELL DRILLERS LOG

Date: 2-10, 1961, Driller: W. J. REEVES & SON County: MONROE

72-12 219-9,10,12 1130-12

(Name)

(1) Owner of Land: J. E. SMITH
(Name)

RT. 2 NETTLETON, MISS
(Address)

CEN. GRV. RD.
256 8677

(2) Location: NE 1/4, SE 1/4, Sec. 20 T. 13 R. 6

6 miles S, of NETTLETON
(distance) (direction) (Nearest Town)

(3) Topography: HILLY
(Hilly) (Flat) (Level)

(4) Purpose of Well: DOMESTIC
(Domestic Irrigation
Municipal, Industrial, Other)

Description & Color of Materials Sand, Clay, Red Clay, Shell, etc.	Thick- ness Feet	Depth Feet
CLAY	18	0
BLUE CLAY	14	18
BLUE SANDY CLAY	60	32
BLUE SAND-CLAY STRKS.	85	92

CODED

Information upon completion of well:

(1) Diameter 4 inches. GOOD WATER

(2) Total Depth 177 feet.

(3) Water Level 72 feet below top of ground.

(4) Cased to 23, Size 4


(5) Screen: Size _____, Length _____

(6) Were any formations sealed against pollution?
_____ yes, _____ no.

If YES depth of formation _____

Why _____

Drillers Remarks: _____

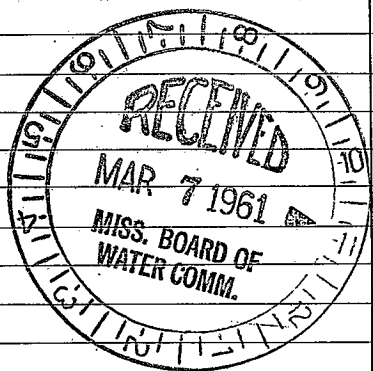

(Use Back Side)

Well No.

