

B 301

B47

WATER WELL DRILLERS LOG

CODED

12-20-60

Herndon Well & Supply Co.

Date: 12/20, 1960, Driller: SHANNON, MISS. County Monroe

(Name)

Gen. Grv. Rd.

(1) Owner of Land: W.H. Early

(Name)

256 8738

Rt 1 Aberdeen

(Address)

(2) Location: NW 1/4, SE 1/4, Sec. 30, T. 29 N., R. 7 E.

6 miles SE of Nettles

(distance)

(direction)

(Nearest Town)

(3) Topography: Flat

(Hilly)

(Flat)

(Level)

(4) Purpose of Well: Home Use

(Domestic Irrigation
Municipal, Industrial, Other)

Information upon completion of well:

(1) Diameter 4 inches.

WELL NOT IN USE

(2) Total Depth 205 feet.

(3) Water Level 115 feet below top of ground.

(4) Cased to 31 ft, Size 4 in.

(5) Screen: Size _____, Length _____

(6) Were any formations sealed against pollution?

yes, no.

If YES depth of formation 25 ft

Why Surface & Sand

Drillers Remarks:

Description & Color of Materials
Sand, Clay, Red Clay, Shell, etc.

Thick-
ness
Feet

Depth
Feet

sand & clay

25

Blue Rock


Sand

100

Bottom

205

CODED

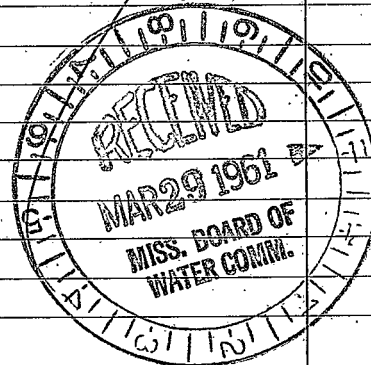

(Use Back Side)

Well No.

